
FORM 51 Stafford KANSAS

Section 22 Township 21 Range 13W

Well No. #1 Hoffman

Company ~~L. Isern & Geo. Angle~~

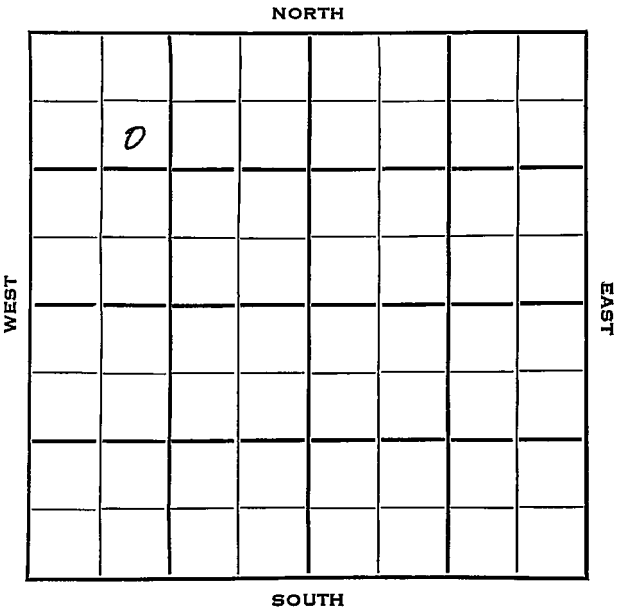

FORM 252-B

Stafford KANSAS ✓

Sec. 22 Twp. 21 R. 13 W

Well No. # 1 Hoffman Farm

L. Isern & Geo. Angle Company

Adkins Contractor

Grow Pool


990 Ft. from N. Line

Ft. from S. Line

Ft. from E. Line

990 Ft. from W. Line

SE NW NW

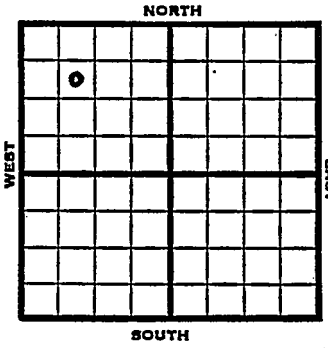

1953	Elev. 1888' REPORT
3/25	RUR
4/2	8" @ 213 Anhy 765 Drlg 2037
4/9	Heeb 3212' Br li 3340' Lans 3356 B KC 3571 V 3613 Simp. 3665' Arb. 3716' Circu. @ 3735
4/15	Spud 3-25-53 D&A TD 3735 8" @ 213 Anhy 765, Heeb 3212, Br lime3340, Lans 3356, B KC 3571, Viola 3613, Simp 3665, Arb. 3716 TD 3735 D&A

ABANDONED

FORM 275 FOR SALE BY KANSAS BLUE PRINT CO.


County Stafford State Kansas

Sec. 22 (Blk. Twp.) 21 (Sur. Rge.) 13W Map No.

Operator L. Isern & Geo. Angle

Well No. 1 Farm Hoffman

Elev. Location SE NW NW

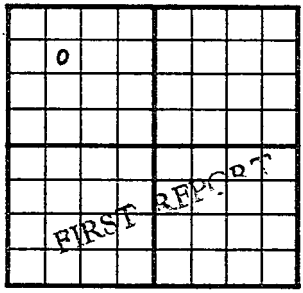

990 Ft. From N Line NW

990 Ft. From W Line Quarter

1st. Report MAR 25 1953

Completion

Remarks Adkins - Contr.

Spudding Date Grow Pool

Drlg. Data

R U R

J. G. McGEHEE

FORM 275 FOR SALE BY KANSAS BLUE PRINT CO.

County Stafford State Kansas

Sec. 22 (Blk. Twp.) 21 (Sur. Rge.) 13W Map No.

Operator L. Isern & Geo. Angle

Well No. 1 Farm Hoffman

Elev. 1888 Location SE NW NW



990 Ft. From N Line NW

990 Ft. From W Line Quarter

1st. Report

Completion APR 1 5 1953

Remarks Grow Pool

Adkins - Contr.

Spudding Date 3-25-53

Drlg. Data D & A TD 3735

8" @ 213 Anhy 765 Heeb. 3212

Br. lime 3340 Lans. 3356 B KC 3571

Viola 3613 Simp. 3665 Arb. 3716

TD 3735

D & A

J. G. McGEHEE