

KANSAS

Stafford


FORM 51 5M PETROL

Section 22- Township 21 Range 13W

Well No. #2' Krone

Company Phillips

Gate s Pool

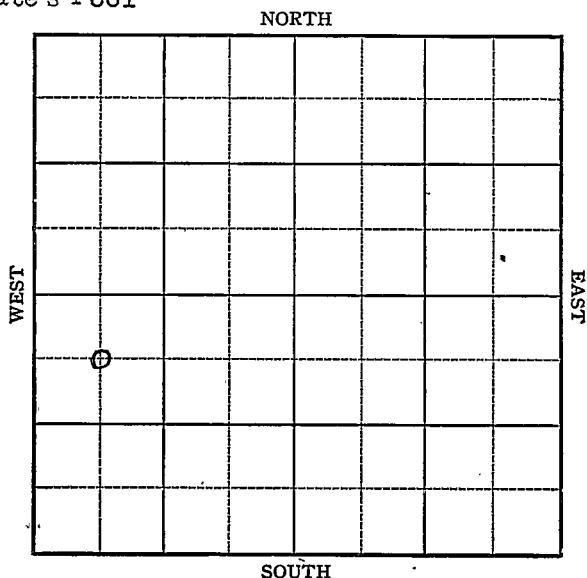

KANSAS

Stafford

Sec. 22 Twp. 21 R. 13-WWell No. #2, Krone FarmPhillips Company660


Ft. from N. Line

Ft. from S. Line

Ft. from E. Line

660

Ft. from W. Line

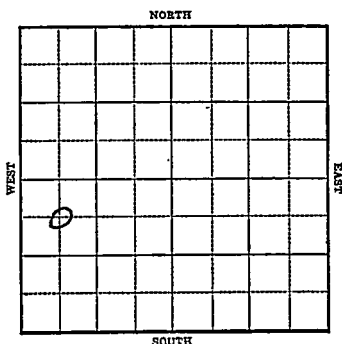Elev. 1887

R E P O R T

1943
12/15

Rotary

12/22

8" @ 376'

Drlg. 1725'

12/29

Drlg 3375'

1944

1-5

Lans 3347

Cong 3597

Simp 3626

Arb 3676-78 TD Sat

7" @ 3676

RUST

1-12

"

"

1/19

TD 3695

500 acid

Testing.

1/26

TD 3718-500 acid

12 gals oil PH in 4 hrs.

2/2

400' oil & 200 water in 5 days

2/8

PB 3698

10 qts 3689-91 swb 6 fluid in 5 hrs.

2/15

TD 3751-1000' oil 300' water

SD

2/23

PB 3640 12 shots 3609-12

12 shots 3617-21-4 gals oil per hr 6 h

OVER

1944

3/1

5" @ 3676

Arb 3676

TD 3751

Water

ABANDONED

~~KANSAS~~
 Map No. 8 Sec. 22 Twp. 21 R. 13W

Well No. 2 Krone

Phillips Company

FIRST REPORT Contractor

C NW SW

SECTION PLAT

660 Ft. from N. Line

 Ft. from S. Line

 Ft. from E. Line

660 Ft. from W. Line

o			

Gates Pool

Location

Rig up

Drilling and Remarks:

Rotary

RECORD

Cased in., ft.

Sand

Gas

Oil

Total Depth

PRODUCTION

1st 24 hrs. Nat.

1st 24 hrs. after shot

Gas Cu. Ft.

Dry Hole

Abandoned

Date

DEC 15 1943

19

S. J. LEWIS Scout



Misc. Small Maps	<i>One</i>
Cards	<i>Madge</i>
Tracing	<i>MEZ</i>
Franco Map	<i>✓</i>
Scarborough Map	<i>MEZ</i>
Woody Map	<i>MEZ</i>
Ecological Dept.	
Woody Print Book	

KANSAS
 Map No. 82 Sec. 22 Twp. 21 R. 13W

Well No. 2 Krone

Phillips Company

ABANDONED Contractor

C NW SW


SECTION PLAT

660 Ft. from N. Line

 Ft. from S. Line

 Ft. from E. Line

660 Ft. from W. Line

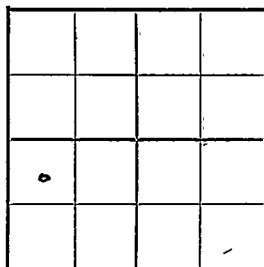

Gates Pool

Location

Rig up

Drilling and Remarks:

Cr 83676

5' 03 676

Water

RECORD

Cased in., ft.

Sand

Gas

Oil

Total Depth 37.51

PRODUCTION

1st 24 hrs. Nat.

1st 24 hrs. after shot

Gas Cu. Ft.

Dry Hole

Abandoned

Date

MAR 1 1944 19 S. J. LEWIS Scout

Misc. Small Map
Cards *Wadges*
Tracing *M & L*
France Map
Scarborough Map
Woody Map
Zoological Dept.
Woody Plat Book