

# KANSAS

Form 51-5M-7-39-Palace


Rice

Section 22 Township 21 Range 9-W

Well No. #2 Partington

Company Schneider & Pulse & Renie

NORTH **Miscellaneous**

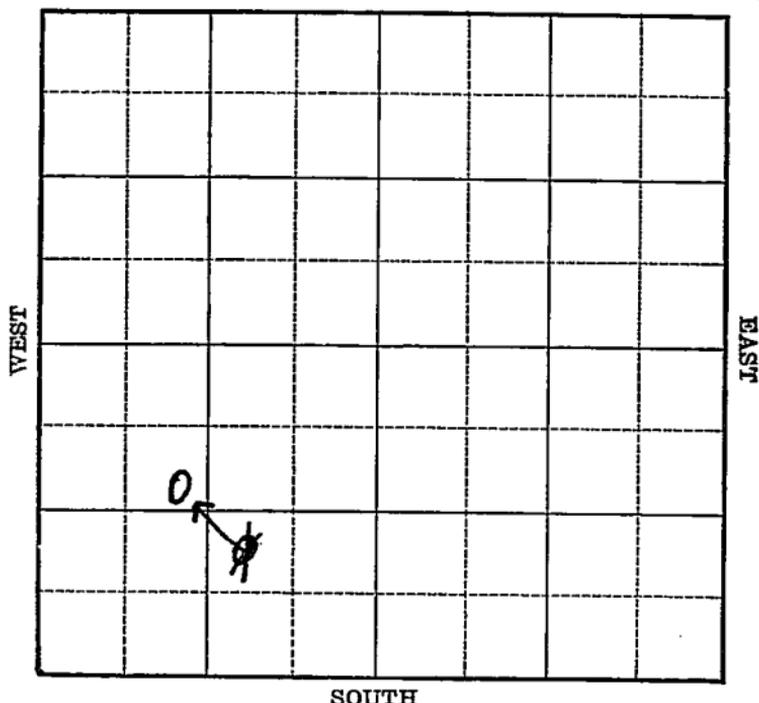



Rice

KANSAS

Map No. \_\_\_\_\_ Sec. 22 Twp. 21 R. 9W

Well No. 2 Partington

Schneider & Pulse & Rennie  
Company

Contractor

FIRST REPORT

NW SE SW

SECTION PLAT

\_\_\_\_\_ Ft. from N. Line

990 Ft. from S. Line

990 Ft. from E. Line

\_\_\_\_\_ Ft. from W. Line

	o		

MISCELLANEOUS

Location \_\_\_\_\_

Rig up \_\_\_\_\_

Drilling and Remarks:  
**Derrick**

RECORD

Cased \_\_\_\_\_ in., \_\_\_\_\_ ft.

Sand \_\_\_\_\_

Gas \_\_\_\_\_

Oil \_\_\_\_\_

Total Depth \_\_\_\_\_

PRODUCTION

1st 24 hrs. Nat. \_\_\_\_\_

1st 24 hrs. after shot \_\_\_\_\_

Gas \_\_\_\_\_ Cu. Ft.

Dry Hole \_\_\_\_\_

Abandoned \_\_\_\_\_

Date

OCT 4 1923

S. J. LEWIS Scout

Rice **KANSAS**

Map No. 49 Sec. 22 Twp. 21 R. 9W

Well No. 2 Partington

Schneider, Pulse & Renie Company

CORRECTION Contractor

**SECTION PLAT**

SE NW SW


1024 Ft. from N. Line

\_\_\_\_\_ Ft. from S. Line

\_\_\_\_\_ Ft. from E. Line

1080 Ft. from W. Line

**MISCELLANEOUS**

Location \_\_\_\_\_

Rig up \_\_\_\_\_

Drilling and Remarks: ^

**Reported:**

NW SE SW

**RECORD**

Cased \_\_\_\_\_ in., \_\_\_\_\_ ft.

Sand \_\_\_\_\_

Gas \_\_\_\_\_

Oil \_\_\_\_\_

Total Depth \_\_\_\_\_

**PRODUCTION**

1st 24 hrs. Nat. \_\_\_\_\_

1st 24 hrs. after shot \_\_\_\_\_

Gas \_\_\_\_\_ Cu. Ft.

Dry Hole \_\_\_\_\_

Abandoned \_\_\_\_\_

Date

OCT 1

19

S. J. LEWIS

Scout

Rice

KANSAS

Map No. 49 Sec. 22 Twp. 21 R. 9WWell No. 2 PartingtonSchneider, Pulse & Renie Company

Contractor

COMPLETED

## SECTION PLAT

SE NW SW  
1024 Ft. from N. Line

\_\_\_\_\_ Ft. from S. Line

\_\_\_\_\_ Ft. from E. Line

1080 Ft. from W. Line


## MISCELLANEOUS

## RECORD

Location \_\_\_\_\_

Cased \_\_\_\_\_ in., \_\_\_\_\_ ft.

Rig up \_\_\_\_\_

Sand \_\_\_\_\_

Drilling and Remarks:

Gas \_\_\_\_\_

*Masiner 3318*

Oil \_\_\_\_\_

*5" @ 3317*Total Depth 3380*16M Gas*

## PRODUCTION

1st 24 hrs. Nat. \_\_\_\_\_

1st 24 hrs. after shot \_\_\_\_\_

Gas \_\_\_\_\_ Cu. Ft.

Dry Hole \_\_\_\_\_

Abandoned \_\_\_\_\_

Date

NOV 1 1939<sub>19</sub>

S. J. LEWIS Scout