


# Rice County Kansas

Section 22 Township 21 Range 9W

Well No. 1 Wellman

Company Gerbrand Pulse etal

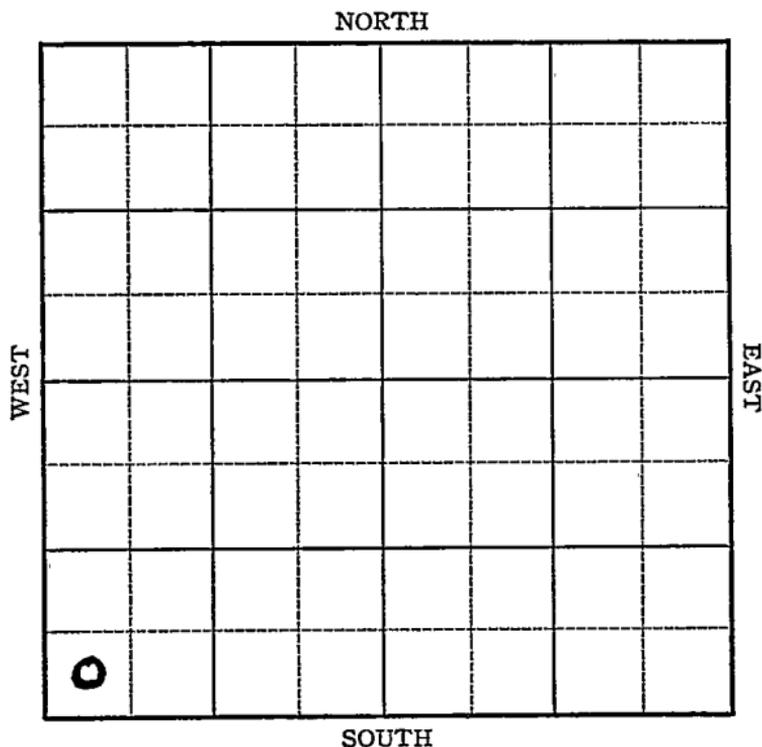

Sec. 22 Twp. 21 R. 9-W

Well No. #1 Wellman Farm


Gerbrand-Pulse et al Company

\_\_\_\_\_ Ft. from N. Line

330 Ft. from S. Line.

\_\_\_\_\_ Ft. from E. Line

330 Ft. from W. Line

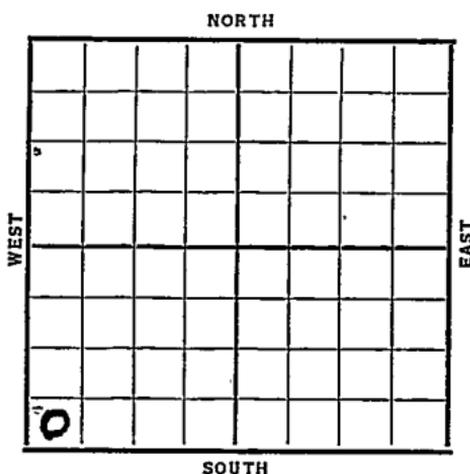

| Date  | REPORT                      |
|-------|-----------------------------|
| 1937  |                             |
| 7/28  | R. U.                       |
| 8/6   | Spud.                       |
| 8/13  | 15" @ 54'. Drlg. 910'.      |
| 8/20  | T.D. 1185'. SD for pipe.    |
| 8/28  | 12" @ 1194'. Drlg. 1220'.   |
| 9/3   | T.D. 1810'. Rng. 10".       |
| 9/10  | Fort Riley 1395'.           |
|       | 10" @ 2015'. Drlg. 2230'.   |
| 9/17  | 8" @ 2480'. Topeka 2488'.   |
|       | T.D. 2544'. SD for repairs. |
| 9/24  | T.D. 2785'. U.R. 8".        |
| 10/1  | Top Kansas City 2939        |
|       | Dlq. 2960 No show (Tel).    |
| 10/8  | 8" @ 2774'. K.C. 2939'.     |
|       | Drlg. 3230'.                |
| 10/15 | Cong. 3250'. Est 2 M gas @  |
|       | 3317' T.D. Rig burned down. |
| 10/22 | 7" @ 3298'. C.O.            |
|       | <b>OVER</b>                 |

1937

10/29 Cong. 3308' (Corrected)  
7" @ 3313'. T.D. 3325'.  
Est. 20 M gas.

11/3 6" @ 3313'.  
Cong. 3308'.  
T.D. 3325'.  
22 M cu. ft. gas.  
1120# rock pressure.  
B.T.U. 1040

COMPLETED

*Rice* **KANSAS**

Map No. \_\_\_\_\_ Sec. 22 Twp. 21 R. 9W

Well No. 1 - Wellman

Gerbrand - Pulse et al Company

Contractor \_\_\_\_\_

**FIRST REPORT**

**SECTION PLAT**

\_\_\_\_\_ Ft. from N. Line

330 Ft. from S. Line

\_\_\_\_\_ Ft. from E. Line

330 Ft. from W. Line

|  |  |  |  |
|--|--|--|--|
|  |  |  |  |
|  |  |  |  |
|  |  |  |  |
|  |  |  |  |

Location \_\_\_\_\_

Rig up \_\_\_\_\_

Drilling and Remarks:

*R. U.*

**RECORD**

Cased \_\_\_\_\_ in., \_\_\_\_\_ ft.

Sand \_\_\_\_\_

Gas \_\_\_\_\_

Oil \_\_\_\_\_

Total Depth \_\_\_\_\_

**PRODUCTION**

1st 24 hrs. Nat. \_\_\_\_\_

1st 24 hrs. after shot \_\_\_\_\_

Gas \_\_\_\_\_ Cu. Ft.

Dry Hole \_\_\_\_\_

Abandoned \_\_\_\_\_



*H. D. Hatfield* Scout

KANSAS

Rice

Map No. \_\_\_\_\_ Sec. 22 Twp. 21 R9W

Well No. 1 Wellman

Gerbrand - Pulse etal Company

Contractor

COMPLETED

SW/C

\_\_\_\_\_ Ft. from N. Line

330 Ft. from S. Line

\_\_\_\_\_ Ft. from E. Line

330 Ft. from W. Line

SECTION PLAT

|   |  |  |  |
|---|--|--|--|
|   |  |  |  |
|   |  |  |  |
|   |  |  |  |
| 0 |  |  |  |

Location \_\_\_\_\_

Rig up \_\_\_\_\_

Drilling and Remarks:

*22 M. Cu. Ft. gas*

*1120 # Rock Pres*

*B.T.U. 1040*

RECORD

Cased 6 in., 3313 ft.

Sand Cong 3308

Gas \_\_\_\_\_

Oil \_\_\_\_\_

Total Depth 3325

PRODUCTION

1st 24 hrs. Nat. \_\_\_\_\_

1st 24 hrs. after shot \_\_\_\_\_

Gas \_\_\_\_\_ Cu. Ft.

Dry Hole \_\_\_\_\_

Abandoned \_\_\_\_\_

Date

NOV 3 1937<sub>19</sub>

H. D. Hatfield Scout