


Section 22 Township 21 Range 16W
Well No. 2 Hunsley
Company Petroleum, Inc.

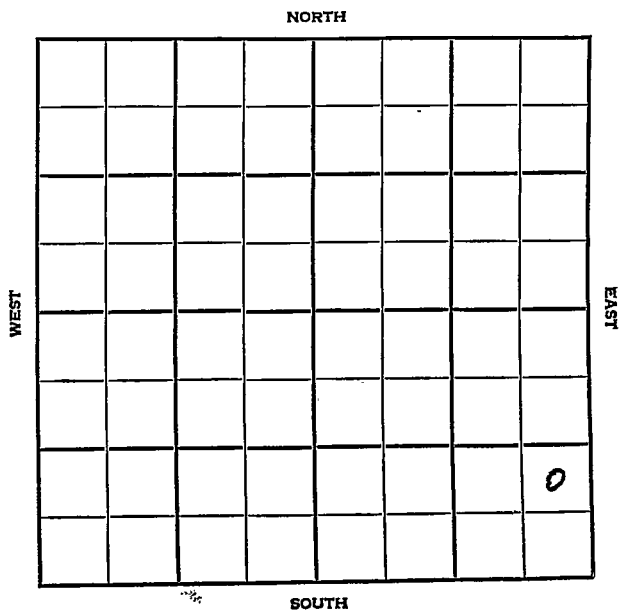

Pawnee

KANSAS

SEC.	TWP.	R.
22	21	16 W

WELL NO.

2 Hunsley FARM

COMPANY

Petroleum Inc.

CONTRACTOR

Co. tools

NE Larned Pool

Ft. from N. Line

990 Ft. from S. Line

330 Ft. from E. Line

Ft. from W. Line

NE SE SE

NORTH							
WEST							
EAST							
SOUTH							

1955

ELEVATION

1982'

REPORT

4/20

Spud 4-16-55
8" @ 987 WOC

