

Finney


KANSAS

SECTION 22 TOWNSHIP 21 RANGE 28W

WELL NO. #1 Chennell

COMPANY Gene Goff & Gulf Oil Corp.

NORTH C SW SW

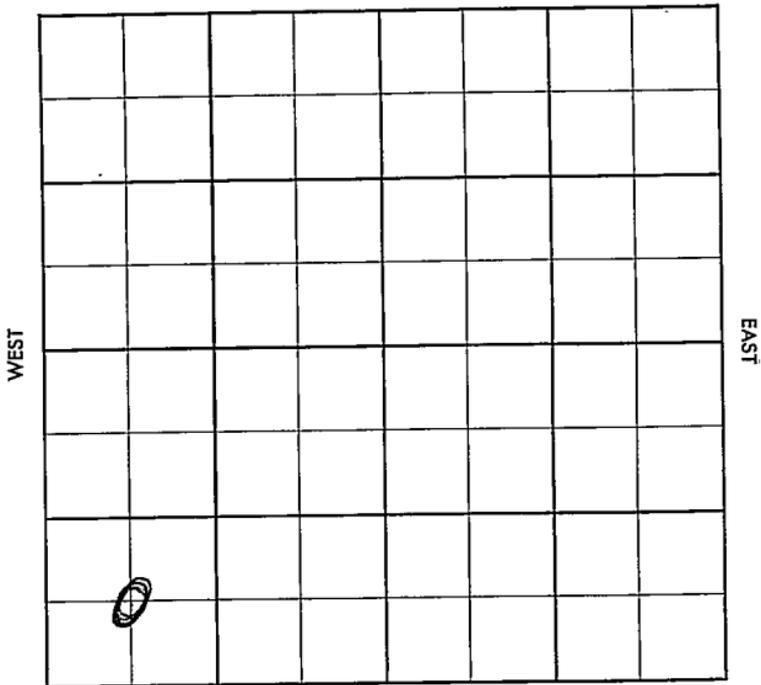

SOUTH

County Finney Elev. _____
 Sec. 22 Twp. 21 Rge. 28W
 Company Gene Goff & Gulf Oil Corp.
 Farm Name Chennell No. 1

TOPS	DEPTH	LOG	DATUM	Loc. in Sec.
Anb.				C SW SW
TP.				
H.				
Tr.				
Dg.				
BL.				
L.				Geol. _____
K.C.				Contr. _____
B.K.C.				Sierra Drlg.
Ce.				Pool _____
C.				Rank WC
M.				
M.				
K.				
Mz.				
Mq.				
V.				
S.				
S.				
A				
R.				
PE.				
G.				
T.D.				

SDX

<i>3/4</i>	JUL 3 '57
<i>mile</i>	
FIRST REPORT	
o	

Date Comm. 6-28-57 Phillips-DHM North. Nat. FO
8" @ 400/200, Drlg. 410

[Handwritten signature]

AG.M

Co.
Use.
No.
Sec.
T.
R.

Co.

Loc.

No.

R.

County Finney Elev. 2757 KB
 Sec. 22 Twp. 21 Rge. 28W
 Company Gene Goff & Gulf Oil Corp.
 FarmName Chennell No. 1

TOPS	DEPTH	LOG	DATUM	Loc. in Sec.
Anh				C SW SW
	2.00			
	2.30			
	2.50			
	2.70	3964		
	3.00			
K.C.	3998	3998		Geol.
B.K.C.				Contr.
Ce. <u>Maim</u>		4390		Sierra Drlg.
C.		4660		Pool
M.				Rank WC
M.				
K.				
Mz.				
Me.				
V.				
S.				
S.				
A.				
R.				
PE.				
G.				
T.D.	4761			<div style="border: 1px solid black; padding: 5px; display: inline-block;"> <p>3/4 mile</p> <p>ABANDONED</p> <p>JUL 24 '57</p> </div>

Date Comm. 6-28-57 Phillips-DHM North.Nat.FO
8" @ 400/200, Drlg. 410 JUL 10 57 # 3586
BLIT 57' DST 4256-78 1hr res 1290
MSW FP 105-750 1270/20 # 4457
JUL 24 '57

D & A