

O.W.W.O. KANSAS^{Finney}Section 22 Township 21 Range 34WWell No. 2 LockmanCompany Shallow Water Ref.

Nunn Pool

NORTH

WEST

EAST

					0		

SOUTH

Sec. 22 Twp. 21 R. 34WWell No. 2 Lockman Farm

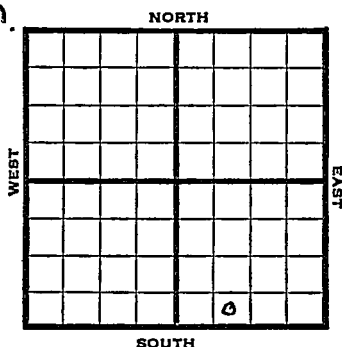
Shallow Water Ref. _____ Company

Nunn Pool O.W.W.O.

_____ Ft. from N. Line

330 Ft. from S. Line

_____ Ft. from E. Line

990 Ft. from W. Line

SE SW SE

1948 Eli 2958' REPORT

9/22 300' run 10"
9/29 13" @ 345'
Drlg. 3352'
10/6 Drlg. 4308'
10/13 Drlg. 4647'
10/19 Mississippi 4635'
TD 4716'
5" @ 4628'
10/26 "
11/3 72' of 4" liner
11/10 "
11/16 "
11/23 "
11/30 "
12/8 TD 4716'
Miss 4635'
Aband.

ABANDONED

1950

O.W.W.O.

11/1 Marmaton 4308' Miss 4635'
OTD 4716' 5" @ 4628'
Was Abd.
SP 4266 48/4216-26 1000 A
FU 300' wtr no oil 1 hr to perf.

VIEW

1950

11/8 D&A

Marmaton 4308' Miss 4635'

OTD 4716' 5" @ 4628'

SP 4266 48/4216-26 1000 A

FU 300' wtr no oil 1 hr SP 4130

24/4095-4103 FU 400' wtr SP 4054

48/4020-34 1000 A FU 200' wtr

D&A

ABANDONED

Finnery County Kansas State

Map No. _____ Sec. 22 Twp. 21 R. 34W

Well No. 2 Lockman

Shallow Water Ref. Company

FIRST REPORT

Contractor

SE SW SE

SECTION PLAT

Ft. from N. Line

330 Ft. from S. Line

Ft. from E. Line

990 Ft. from W. Line

A blank 10x10 grid with a horizontal line across the middle and a small circle in the bottom right corner.

Nunn Pool

Remarks:

300 run 10"

Date
SEP 22 1948

Scout S. J. LEWIS

Map No. _____ Sec. 22 Twp. 21 R. _____

Well No. 2 Lockman

Shallow Water Ref. _____ Company _____

ABANDONED

Contractor _____

SE SW SE

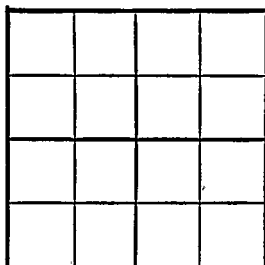
E 1,295
SECTION PLAT

_____ Ft. from N. Line

330 Ft. from S. Line

_____ Ft. from E. Line

990 Ft. from W. Line



Finney County

Location _____

Rig up _____

Drilling and Remarks:

Mcs 4685.

RECORD

Cased _____ in., _____ ft.

Sand _____

Gas _____

Oil _____

Total Depth 10726

PRODUCTION

1st 24 hrs. Nat. _____

1st 24 hrs. after shot _____

Gas _____ Cu. Ft.

Dry Hole _____

Abandoned _____

Date

DEC 8 1948 19 S. J. LEWIS Scout

County Finney State Kansas

Sec. 22 (Blk. Twp.) 21 (Sur. Rge.) 34W Map No.

Operator **Shallow Water Ref.**

Well No. **2** Farm **Lockman**

Elev.	2958	Location	SE SW SE
-------	------	----------	----------

0

330 Ft. From S Line SE

990 Ft. From W Line Quarter

1st. Report NOV 1 1956

Completion

Remarks (~~ONE~~ TWO)

Spudding Date

Drbg. Data . Hugoton Pool

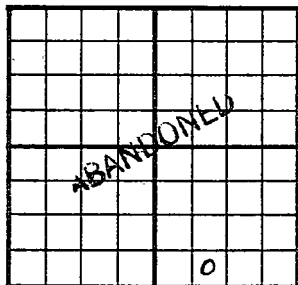
Marmaton 4308 Miss. 4635 OTD 4716

5th @ 4628 Was Abd.

SP 4266 48/ 4216-26 1000 A

IN 300' water no oil 1 hr. to perf.

J. E. TYRA

County Finney State KansasSec. 22 (Blk.) 21 (Sur.) 34W Map No.Operator Shallow Water Ref.Well No. 2 Farm LookmanElev. 2958 Location SE SW SE330 Ft. From S Line SE990 Ft. From W Line Quarter1st. ReportCompletion NOV 8 1950Remarks OWWOSpudding DateDrig. Data D & A Hugoton PoolMarmaton 4308 Miss. 4635 OTD 47165" @ 4628 SP 4266 48/ 4216-26 1000 AFU 300' water no oil 1 hr. SP 413024/ 4095-4103 FU 400' water SP 405448/ 4020-34 1000 A FU 200' waterD & A

J. E. TYRA