


SECTION 22 TOWNSHIP 21S RANGE 34W

WELL NO. #1-Lang

COMPANY E. F. Wakefield & Shallowater
C NW NE

NORTH

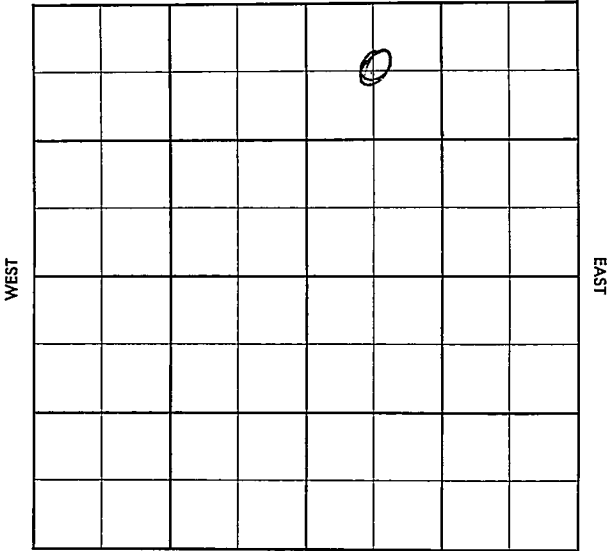

SOUTH

WEST

EAST

4655
2068
7687

60-P

FORM 513 SUNRAY

County Finney Elev. 2968
 Sec. 22 Twp. 21 Rgs. 34W
 Company E. F. Wakefield & shallowater
 Farm Name Lang No. I

TOPS	DEPTH	LOG	DATUM	Loc. in Sec.
Anh.				C NW NE
TP.				4800' test
H.				3/4 mi. N Nunn
Tr.				Pool
Dg.				Geol.
Bl.				Contr.
L.				Co. Tools
K.C.				Pool NUNN
B.K.C.				Wildcat
Ce. <u>Martin</u>	<u>4234</u>			<div style="border: 1px solid black; padding: 5px; text-align: center;"> <p>COMPLETE</p> <p>SEP 25 57</p> </div>
C.				
M.	<u>4655</u>			
K.				
Mz.				
Mo.				
V.				
S.				
A.				
R.				
PE.				
G.				
TD.	<u>4755</u>			

Date Comm. 7-14-57
8 5/8" @ 271/250, Dlg. 1050 - ϕ 3892
... DST 4315-84 1hr 240' oil
+ 210' OCM FP 20-200 BHP 400
120" crd 4625-55 run 28' crg
ahead. ... crd 4655-80 Full rec.
DST 4650-80 1hr 10' Md All pass 0
crd 4680-4730 Full rec. crd 4730
-55 Full rec 5 1/2 4656/300 RUG: 45'
ca 4700 h/ no show PB 4600

24/4412-18 \$ Lots wtvt+550

5 Ad. CO 4400 48/4382-

94 11 \$ 15 BOPH 120/W 24hrs

~~15~~ AUG 21 37 \$ 4 1/2 BOPH/NW 22hrs

15 \$ 10 BOPH + 10 BW / 24hrs POP 6.33.9°

AUG 28 37 P. 92 B0 + 95 BW 24

how 4 days. SEP 4 37 SEP 11 37 SEP 18 37

P 100 Oil 6 100 w pd SEP 25 37

31 BU pd