

Finney County

Nunn Pool

KANSAS


FORM 51 10M 8-47

Section 22 Township 21 Range 34WWell No. #1 LockmanCompany Shallow Water Ref.

NORTH

WEST

EAST

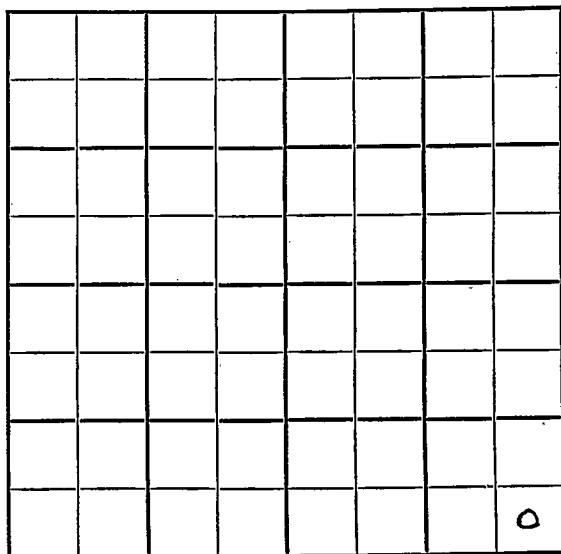

SOUTH

KANSAS Finney

Sec. 22 Twp. 21 R. 34W

Well No. #1 Lockman Farm

Shallow Water Ref. Company

Nunn


 Ft. from N. Line

330 Ft. from S. Line

330 Ft. from E. Line

 Ft. from W. Line

SE/C

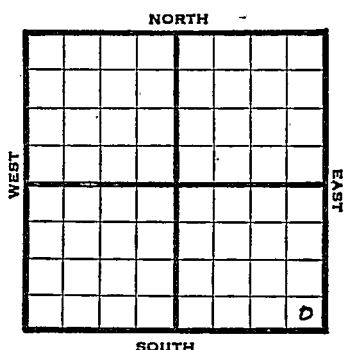

1947 Elev. 2955' REPORT

12/30 Location

1948
1/7 RUR

1/14 8" @ 266'
WOC

1/21 Drlg. 3972'

1/26 Drlg 4500'

2/4 Miss. 4601'-49'
TD 4649'
5" @ 4649'
RUST

2/11 "

2/18 "

2/25 "

3/3 TD 4748'
40 Shots 4614-22
SD

3/10 "

3/17 "

OVER

Map No. _____ Sec. 22 Twp. 21 R. 34W

Well No. 1 Lockman

Shallow Water ^Ref. _____ Company _____

FIRST REPORT _____ Contractor _____

SE/C

SECTION PLAT

			2

_____ Ft. from N. Line

330 Ft. from S. Line

330 Ft. from E. Line

_____ Ft. from W. Line

Finney County

Location X

Rig up _____

Drilling and Remarks:

RECORD

Cased _____ in., _____ ft.

Sand _____

Gas _____

Oil _____

Total Depth _____

PRODUCTION

1st 24 hrs. Nat. _____

1st 24 hrs. after shot _____

Gas _____ Cu. Ft.

Dry Hole _____

Abandoned _____

Date

DEC 30 1947 19

S. J. LEWIS Scout

Kansas

Map No. No Map Sec. 22 Twp. 21 R. 34WWell No. 1 Lockman

Shallow Water Ref. _____ Company _____

COMPLETE

Contractor _____

SE/C


E1.2953

SECTION PLAT

_____ Ft. from N. Line

330 Ft. from S. Line330 Ft. from E. Line

_____ Ft. from W. Line

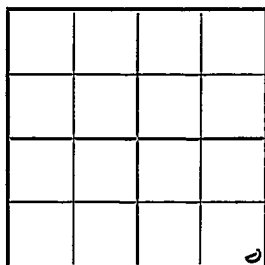

Finney County

Location _____

Rig up _____

Drilling and Remarks:

*Miss 4601**5" @ 4649**5-426 to 4276-85-**in Perm 4257 Twp.**9000 acid**Run 615 ft**27 1/2 ft*

RECORD

Cased _____ in., _____ ft.

Sand _____

Gas _____

Oil _____

Total Depth 7740

PRODUCTION

1st 24 hrs. Nat. _____

1st 24 hrs. after shot _____

Gas _____ Cu. Ft.

Dry Hole _____

Abandoned _____

Date

MAR 24 1948

19

S. J. LEWIS

Scout

1948

3/24 Miss 4601'
5" @ 4649'
54 Shots 4276-85' in Marm 4281 top.
9000 Acid
Pump 615 Pot.
Gr. 27°
TD 4748'

COMPLETED