


Stafford

KANSAS

SECTION 22 TOWNSHIP 21S RANGE 12W

WELL NO. #6 Rose

COMPANY Virginia Drlg.

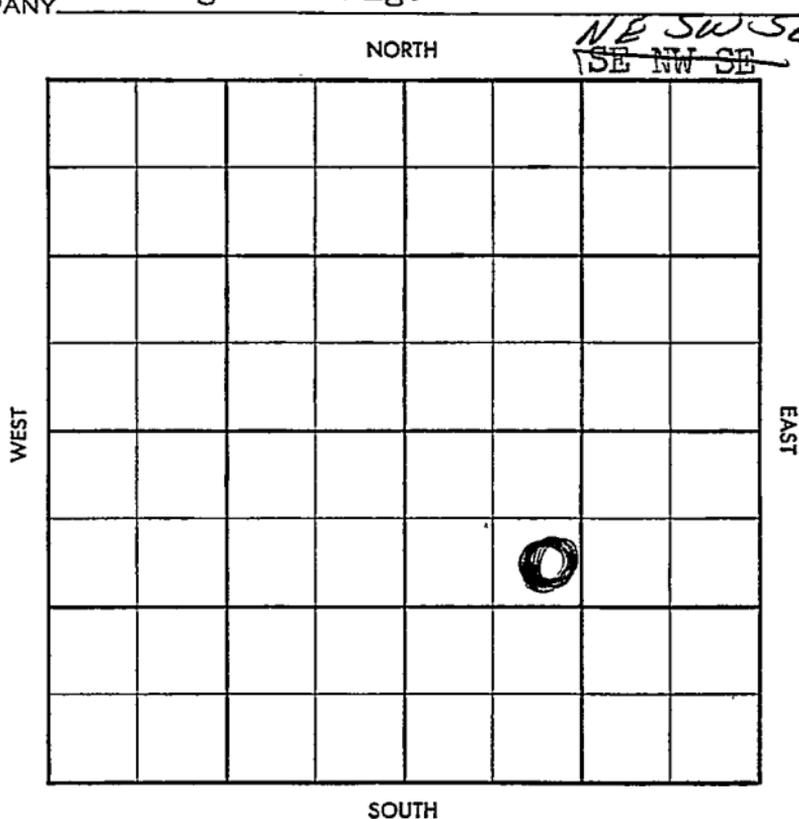



S-513-A

CO. St. Ford ELEV. _____
SEC. 22 TWP. 21 RGE. 12W
COMPANY Virginia Dril NO. 6

CO.

LSE.

NO.


SEC.

TWP.

RGE.

FARM Rose
LOC. SE 1/4 SE

GEOL. _____
CONTR. Co. Tools
POOL Sandra
SPUD _____
Location

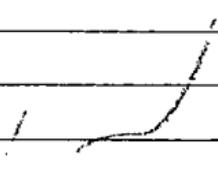

CORRECTION

13

S-513-A

CO. St. fford ELEV 1849
SEC. 22 TWP. 21 RGE. 12W
COMPANY Virginia Dril NO. 6

ABANDONED
DEC 4 '57

FARM Rose

LOC. ~~_____~~ me. out se

GEOL. _____
CONTR. Co. Tools
POOL Saundra
SPUD _____
Location ~~_____~~ Loc
NOV 6 '57 SD
NOV _____

abandon loc

1 SE.
NO.
SEC.
TWP.
RGE.