

And

STATE CORPORATION COMMISSION OF KANSAS
OIL & GAS CONSERVATION DIVISION
WELL COMPLETION OR RECOMPLETION FORM
ACO-1 WELL HISTORY
DESCRIPTION OF WELL AND LEASE

Operator: License # 5316
Name Falcon Exploration
Address Suite 1531 KSB Bldg.
City/State/Zip Wichita, KS 67202

Purchaser

Operator Contact Person Mike Mitchell
Phone 316-262-1378

Contractor: License # 9087
Name R & C Drilling

Wellsite Geologist Craig Snider
Phone 316-262-1378

Designate Type of Completion
 New Well Re-Entry Workover
 Oil SWD Temp Abd
 Gas Inj Delayed Comp.
 Dry Other (Core, Water Supply etc.)
If **OWWO**: old well Info as follows:
Operator
Well Name
Comp. Date Old Total Depth

WELL HISTORY

Drilling Method:
2 Mud Rotary Air Rotary Cable
3-27-86 3-6-86 3-7-86
Spud Date Date Reached TD Completion Date
4550
Total Depth PBTD

Amount of Surface Pipe Set and Cemented at 557 feet
Multiple Stage Cementing Collar Used? Yes No
If yes, show depth set.....feet
if alternate 2 completion, cement circulated
from.....feet depth to.....w/.....SX cmt
Cement Company Name
Invoice #

API NO. 15-083-21-247
County Hodgeman
C NE NE SW Sec. 1 Twp. 21 Rge. 23 East West

2310 Ft North from Southeast Corner of Section
2970 Ft West from Southeast Corner of Section
(Note: Locate well in section plat below)


Lease Name Waterhouse Well # 1

Field Name

Producing Formation

Elevation: Ground 2289' KB 2294'

Section Plat

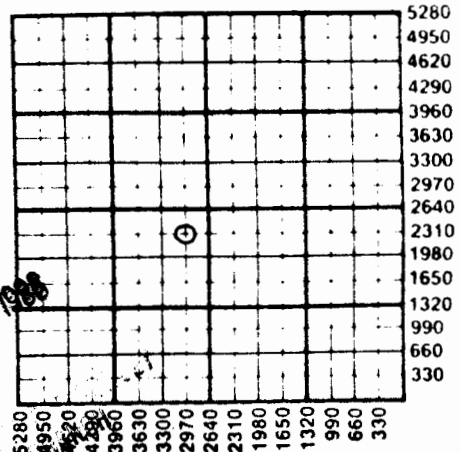

WATER SUPPLY INFORMATION

Disposition of Produced Water: Disposal
Docket # Repressuring
Bob Frusher, Hanston, KS Irrigation well

Questions on this portion of the ACO-1 call:
Water Resources Board (913) 296-3717

Source of Water:
Division of Water Resources Permit #

Groundwater.....Ft North from Southeast Corner
(Well)Ft West from Southeast Corner of
Sec Twp Rge East West

Surface Water.....Ft North from Southeast Corner
(Stream, pond etc).....Ft West from Southeast Corner
Sec Twp Rge East West

Other (explain).....
(purchased from city, R.W.D. #)

INSTRUCTIONS: This form shall be completed in duplicate and filed with the Kansas Corporation Commission, 200 Colorado Derby Building, Wichita, Kansas 67202, within 90 days after completion or recompletion of any well. Rule 82-3-130 and 82-3-107 apply.

Information on side two of this form will be held confidential for a period of 12 months if requested in writing and submitted with the form. See rule 82-3-107 for confidentiality in excess of 12 months. One copy of all wireline logs and drillers time log shall be attached with this form. Submit CP-4 form with all plugged wells. Submit CP-111 form with all temporarily abandoned wells.