

STATE CORPORATION COMMISSION OF KANSAS
OIL & GAS CONSERVATION DIVISION
WELL COMPLETION OR RECOMPLETION FORM
ACO-1 WELL HISTORY
DESCRIPTION OF WELL AND LEASE

Operator: License # 4808
Name Smokey Oil Company
Address P. O. Box 2360
City/State/Zip Casper, WY 82602

Purchaser.....

Operator Contact Person C. F. Pickard
Phone 307-266-0230

Contractor: License # 4708
Name True Drilling Company

Wellsite Geologist Roger Matson
Phone 303-741-1231

Designate Type of Completion

☒ New Well ☐ Re-Entry ☐ Workover
☐ Oil ☐ SWD ☐ Temp Abd
☐ Gas ☐ Inj ☐ Delayed Comp.
☒ Dry ☐ Other (Core, Water Supply etc.)

If ONWO: old well info as follows:

Operator
Well Name
Comp. Date Old Total Depth.....

WELL HISTORY

Drilling Method:

☒ Mud Rotary ☐ Air Rotary ☐ Cable

3/5/86 3/10/86 4/12/86
Spud Date Date Reached TD Completion Date

4510 None
Total Depth PBTD

Amount of Surface Pipe Set and Cemented at 441 feet
Multiple Stage Cementing Collar Used? ☐ Yes ☐ No
If yes, show depth set.....feet
If alternate 2 completion, cement circulated
from.....feet depth to.....w/.....SX cmt
Cement Company Name Halliburton
Invoice #

API NO. 15-083-21,246

County Hodgeman

C NE NE Sec 7 Twp 21S Rge 23 East
..... West

4620 Ft North from Southeast Corner of Section
660 Ft West from Southeast Corner of Section

(Note: Locate well in section plat below)


Lease Name Brady Well # 41-7

Field Name Wildcat

Producing Formation.....

Elevation: Ground 2277 KB 2292

Section Plat

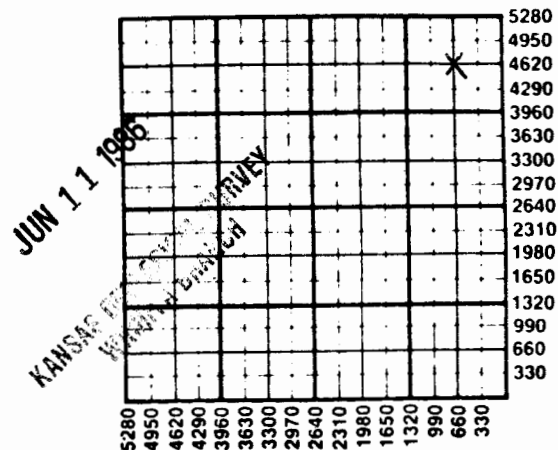

WATER SUPPLY INFORMATION

Disposition of Produced Water: N/A Disposal
Docket # Repressuring

Questions on this portion of the ACO-1 call:

Water Resources Board (913) 296-3717

Source of Water:

Division of Water Resources Permit #.....

Groundwater.....Ft North from Southeast Corner
(Well) Ft West from Southeast Corner of
Sec Twp Rge East West

Surface Water.....Ft North from Southeast Corner
(Stream, pond etc).....Ft West from Southeast Corner
Sec Twp Rge East West

Other (explain) Private landowner - water well
(SW 1/4 Sec 9; T11N-R58W
(purchased from city, R.W.D. #)

INSTRUCTIONS: This form shall be completed in duplicate and filed with the Kansas Corporation Commission, 200 Colorado Derby Building, Wichita, Kansas 67202, within 90 days after completion or recompletion of any well. Rule 82-3-130 and 82-3-107 apply.

Information on side two of this form will be held confidential for a period of 12 months if requested in writing and submitted with the form. See rule 82-3-107 for confidentiality in excess of 12 months. One copy of all wireline logs and drillers time log shall be attached with this form. Submit CP-4 form with all plugged wells. Submit CP-111 form with all temporarily abandoned wells.

All requirements of the statutes, rules and regulations promulgated to regulate the oil and gas industry have

SIDE TWO

Operator Name Smokey Oil Company Lease Name..... Brady Well #..... 41-7
 Sec..... 7 Twp..... 21S Rge..... 23 ☐ East ☒ West County..... Hodgeman

WELL LOG

INSTRUCTIONS: Show important tops and base of formations penetrated. Detail all cores. Report all drill stem tests giving interval tested, time tool open and closed, flowing and shut-in pressures, whether shut-in pressure reached static level, hydrostatic pressures, bottom hole temperature, fluid recovery, and flow rates if gas to surface during test. Attach extra sheet if more space is needed. Attach copy of log.

Drill Stem Tests Taken ☒ Yes ☐ No
 Samples Sent to Geological Survey ☐ Yes ☒ No
 Cores Taken ☐ Yes ☒ No

Formation Description
☒ Log ☐ Sample

DST #1: 4434-54', 15-60-180-180
 Rec. 5' oil, 10' oil speck mud
 HP 2211-2223
 IF 9-13, ISI 1564, FF 18-35, FSI 989
 bht 121'

Name	Top	Bottom
Heebner	3752	
Lansing	3802	
Kansas City	3986	
Marmaton	4240	
Cherokee	4358	
Mississippian	4437	

CASING RECORD ☒ New ☐ Used							
Report all strings set-conductor, surface, intermediate, production, etc.							
Purpose of String	Size Hole Drilled	Size Casing Set (in O.D.)	Weight Lbs/Ft.	Setting Depth	Type of Cement	#Sacks Used	Type and Percent Additives
...Surface.....	...12 1/2...	...8 5/8...	...24#...	...441...	...Lite...	...110...	...3% CaCl...
.....					...Piz...	...120...	"
.....							
PERFORATION RECORD				Acid, Fracture, Shot, Cement Squeeze Record			
Shots Per Foot	Specify Footage of Each Interval Perforated			(Amount and Kind of Material Used)			Depth
.....							
.....							
.....							
.....							
TUBING RECORD				Liner Run ☐ Yes ☐ No			
Date of First Production		Producing Method					
		☐ Flowing ☐ Pumping ☐ Gas Lift ☐ Other (explain).....					