

S SIDE ONE

Incl

f

STATE CORPORATION COMMISSION OF KANSAS
OIL & GAS CONSERVATION DIVISION
WELL COMPLETION OR RECOMPLETION FORM
ACO-1 WELL HISTORY
DESCRIPTION OF WELL AND LEASE

Operator: License # 6999
Name: Antares Oil Corporation
Address: 1546 Cote Blvd. #220
City/State/Zip: Golden, CO 80401

Purchaser: N/A

Operator Contact Person: William Leach
Phone: (303) 232-2290

Contractor: License # 5420
Name: White & Ellis Drilling CO. Rig 8

Wellsite Geologist: D.V. Davis, Jr.
Phone: (316) 264-7464

Designate Type of Completion
 New Well Re-Entry Workover

 Oil SWD Temp Abd
 Gas Inj Delayed Comp.
 Dry Other (Core, Water Supply etc.)

If ONWO: old well info as follows:
Operator
Well Name
Comp. Date Old Total Depth.....


WELL HISTORY

Drilling Method:
 Mud Rotary Air Rotary Cable
10/9/80 10/16/80 10/71/80
.....
Spud Date Date Reached TD Completion Date
4580
.....
Total Depth PBDT

Amount of Surface Pipe Set and Cemented at 339 feet
Multiple Stage Cementing Collar Used? Yes No
If yes, show depth set.....feet
If alternate 2 completion, cement circulated
from.....feet depth to.....w/.....SX cmt
Cement Company Name: Allied Cementing
Invoice #

API NO. 15-083-20737
County: Hodgeman
NE SW NW Sec. 12 Twp. 215 Rge. 23 East
3630
4290
Ft North from Southeast Corner of Section
Ft West from Southeast Corner of Section
(Note: Locate well in section plat below)
Lease Name: Bamburger 1
Well #.....
Field Name: WC (2 1/4 NW of Marena)
Producing Formation: D & A
Elevation: Ground 2312 2317 KB

Section Plat

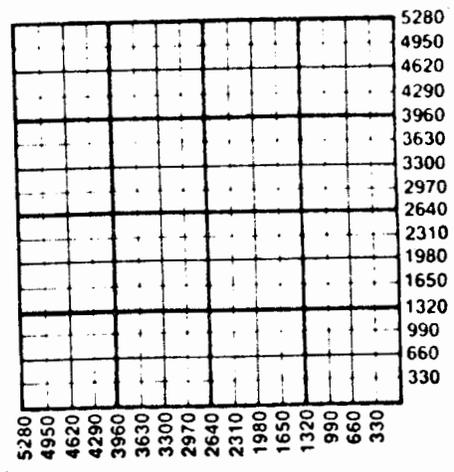

MAY 16 1986
KANSAS DEPARTMENT OF REVENUE

WATER SUPPLY INFORMATION

Disposition of Produced Water: Disposal
Pocket # Repressuring

Questions on this portion of the ACO-1 call:
Water Resources Board (913) 296-3717

Source of Water:
Division of Water Resources Permit #.....

Groundwater.....Ft North from Southeast Corner
(Well)Ft West from Southeast Corner of
Sec Twp Rge East West

Surface Water.....Ft North from Southeast Corner
(Stream, pond etc.).....Ft West from Southeast Corner
Sec Twp Rge East West

Other (explain).....
(purchased from city, R.W.D. #)

INSTRUCTIONS: This form shall be completed in duplicate and filed with the Kansas Corporation Commission, 200 Colorado Derby Building, Wichita, Kansas 67202, within 90 days after completion or recompletion of any well. Rule 82-3-130 and 82-3-107 apply.
Information on side two of this form will be held confidential for a period of 12 months if requested in writing and submitted with the form. See rule 82-3-107 for confidentiality in excess of 12 months.
One copy of all wireline logs and drillers time log shall be attached with this form. Submit CP-4 form with all plugged wells. Submit CP-111 form with all temporarily abandoned wells.

SIDE TWO

Operator Name Antares Oil Corporation Lease Name Bamburgh Well # 1

Sec. 12 Twp. 21 S Rge. 23 East West County Hodgeman

WELL LOG

INSTRUCTIONS: Show important tops and base of formations penetrated. Detail all cores. Report all drill stem tests giving interval tested, time tool open and closed, flowing and shut-in pressures, whether shut-in pressure reached static level, hydrostatic pressures, bottom hole temperature, fluid recovery, and flow rates if gas to surface during test. Attach extra sheet if more space is needed. Attach copy of log.

Drill Stem Tests Taken Yes No
 Samples Sent to Geological Survey Yes No
 Cores Taken Yes No

Formation Description
 Log Sample

Name	Top	Bottom
Heebner	3836	
Lansing	3888	
Stark	4156	
BKC	4226	
Ft. Scott	4421	
Cherokee	4448	
Conglomerate	4506	
Miss Warsaw	4528	
Miss Osage	4549	

MAY 16 1986
 ANSAS REC
 WICHITA

CASING RECORD <input checked="" type="checkbox"/> New <input type="checkbox"/> Used Report all strings set-conductor, surface, intermediate, production, etc.							
Purpose of String	Size Hole Drilled	Size Casing Set (in O.D.)	Weight Lbs/Ft.	Setting Depth	Type of Cement	#Sacks Used	Type and Percent Additives
Surface	12 1/4"	8 5/8	24#	339		200	3% cc, 2% ge
PERFORATION RECORD				Acid, Fracture, Shot, Cement Squeeze Record			
Shots Per Foot	Specify Footage of Each Interval Perforated			(Amount and Kind of Material Used)		Depth	
TUBING RECORD				Liner Run <input type="checkbox"/> Yes <input type="checkbox"/> No			
Date of First Production	Producing Method						
	<input type="checkbox"/> Flowing <input type="checkbox"/> Pumping <input type="checkbox"/> Gas Lift <input type="checkbox"/> Other (explain).....						

DRILLERS LOG

12-21-23W

State Geological Survey
WICHITA BRANCH

OPERATOR: ANTARES OIL CORPORATION, 1546 Cole Blvd. - Suite 220, Golden, Colorado 80401

CONTRACTOR: White & Ellis Drilling, Inc., Box 448, El Dorado, Kansas 67042

Lease Name: Bamburger Well No. 1

Sec. 12 T. 21S R. 23W Spot C NE SW NW

County Hodgeman State Kansas Elevation _____

Casing Record:

Surface: 8 5/8" @ 339' with 200 Sxs. 3% CC
2% Gel

Production: _____ @ _____ with _____ Sxs.

Type Well: D & A Total Depth 4580'

Drilling Commenced: 10-9-80 Drilling Completed 10-16-80

Formation	From	To	Tops
Cellar	0	5	Lansing - 3855'
Shale	5	340	
Shale, Lime	340	665	
Shale	665	1004	
Sand, Shale	1004	1221	
Shale, Lime	1221	3855	
Lime	3855	3943	
Shale, Lime	3943	4336	
Lime	4336	4580	

COMPLETION RECORD

Liner Record: Size _____ From _____ To _____

Cementing Record: _____ Sacks _____