

Orig - State Corp. Comm.  
Copy - B. A. Conner - 357 FPB  
Copy - Mary Crump - Okla. City  
Copy - Well File

State Geological Survey  
WICHITA BRANCH

12-21-234

TYPE

AFFIDAVIT OF COMPLETION FORM

ACO-1 WELL HISTORY

SIDE ONE

Compt. \_\_\_\_\_

Two (2) copies of this form shall be filed with the Kansas Corporation Commission, 200 Colorado Derby Building, Wichita, Kansas 67202, within thirty (30) days after the completion of a well, regardless of how the well was completed.

F Attach separate letter of request if the information is to be held confidential. If confidential, only file one copy. Information on Side One will be of public record and Side Two will then be held confidential.

Applications must be made on dual completion, commingling, salt water disposal, injection and temporarily abandoned wells.

C X Attach one copy only wireline logs (i.e. electrical log, sonic log, gamma ray neutron log, etc.). (Rules 82-2-105 & 82-2-125) KCC# (316) 263-3238. No Log

LICENSE # 5229 EXPIRATION DATE June 30, 1984

OPERATOR Phillips Petroleum Company API NO. 15-083-21,070

ADDRESS Box 287 COUNTY Hodgeman

Great Bend, Kansas 67530 FIELD NW Wieland

\*\* CONTACT PERSON C. D. Dohrer PROD. FORMATION Dry Hole

PHONE 316-793-8421

PURCHASER LEASE Hays-AB

ADDRESS WELL NO. 2

WELL LOCATION NW SE SE

DRILLING Slawson Drilling Company 990 Ft. from South Line and

CONTRACTOR 990 Ft. from East Line of

ADDRESS Great Bend, Kansas 67530 the SE/4 (Qtr.) SEC 12 TWP 21 RGE 23 (W).

PLUGGING Sun Oilwell Cementing Co.

CONTRACTOR

ADDRESS Great Bend, Kansas 67530

TOTAL DEPTH 4518' PBTB

SPUD DATE 7-20-83 DATE COMPLETED 7-29-83

ELEV: GR 2267 DF 2271 KB 2273

DRILLED WITH (CABLE) (ROTARY) (AIR) TOOLS.

DOCKET NO. OF DISPOSAL OR REPRESSURING WELL BEING USED TO DISPOSE OF WATER FROM THIS LEASE

Amount of surface pipe set and cemented 1193.25' DV Tool Used? No

THIS AFFIDAVIT APPLIES TO: (Circle ONE) - Oil, Gas, Shut-in Gas, Dry Disposal, Injection, Temporarily Abandoned, OWWO. Other

ALL REQUIREMENTS OF THE STATUTES, RULES AND REGULATIONS PROMULGATED TO REGULATE THE OIL AND GAS INDUSTRY HAVE BEEN FULLY COMPLIED WITH.

WELL PLAT


(Office Use Only)

KCC

KGS

SWD/REP

PLG.

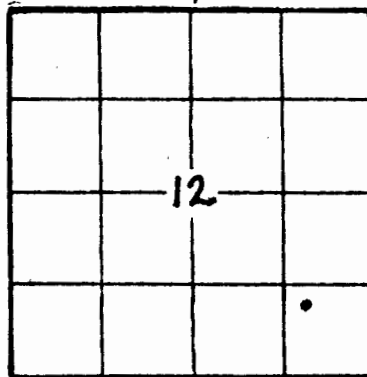

A F F I D A V I T

C. D. Dohrer, being of lawful age, hereby certifies that:

I am the Affiant, and I am familiar with the contents of the foregoing Affidavit. The statements and allegations contained therein are true and correct.

SIDE TWO

ACO-1 WELL HISTORYxxx(x)

 OPERATOR Phillips Petroleum Co. LEASE Hays-AR SEC. 12 TWP. 21 RGF. 23 (W)  
 FILL IN WELL INFORMATION AS REQUIRED: WELL NO. 2 Hodgeman Co., Ks

Show all important zones of porosity and contents thereof; cored intervals, and all drill-stem tests, including depth interval tested, cushion used, time tool open, flowing and shut-in pressures, and recoveries.

SHOW GEOLOGICAL MARKERS, LOGS RUN, OR OTHER DESCRIPTIVE INFORMATION.

| FORMATION DESCRIPTION, CONTENTS, ETC.                                 | TOP   | BOTTOM | NAME            | DEPTH |
|-----------------------------------------------------------------------|-------|--------|-----------------|-------|
| <input checked="" type="checkbox"/> Check if no Drill Stem Tests Run. |       |        |                 |       |
| Surface                                                               | 0'    | 1205'  | Formation Tops: |       |
| Shale & Sand                                                          | 1205' | 2110'  | Heebner         | 3788' |
| Shale                                                                 | 2110' | 2705'  | LKC             | 3834' |
| Lime & Shale                                                          | 2705' | 3200'  | Pawnee Ls       | 4293' |
| Lime & Shale                                                          | 3200' | 3725'  | Ft. Scott       | 4365' |
| Shale & Lime                                                          | 3725' | 4160'  | Cherokee        | 4392' |
| Lime & Shale                                                          | 4160' | 4450'  | Mississippi     | 4438' |
| Shale & Lime                                                          | 4450' | 4518'  |                 |       |
| TD                                                                    | 4518' |        |                 |       |

 State Geological Survey  
 WICHITA BRANCH

If additional space is needed use Page 2, Side 2

Report of all strings set — surface, intermediate, production, etc. CASING RECORD (New) or ~~xxxxxx~~

| Purpose of string | Size hole drilled | Size casing set (in O.D.) | Weight lbs/ft. | Setting depth | Type cement  | Sacks | Type and percent additives       |
|-------------------|-------------------|---------------------------|----------------|---------------|--------------|-------|----------------------------------|
| Surface           | 12 1/4"           | 8 5/8"                    | 24#            | 1202'         | 50-50 Pozmix | 750   | 2% Gel, 3% CaCl, 1/4# Flocele/sk |
|                   |                   |                           |                |               |              |       |                                  |
## LINER RECORD

## PERFORATION RECORD

| Top, ft.      | Bottom, ft.   | Sacks cement  | Shots per ft. | Size & type | Depth interval |
|---------------|---------------|---------------|---------------|-------------|----------------|
|               |               |               |               |             |                |
| TUBING RECORD |               |               |               |             |                |
| Size          | Setting depth | Pecker set at |               |             |                |