

KANSAS


Stafford

FORM 51 IOM, 12-46 PETROL

Section 23 Township 21 Range 12W

Well No. 2nd Maxwell

Company Magnolia

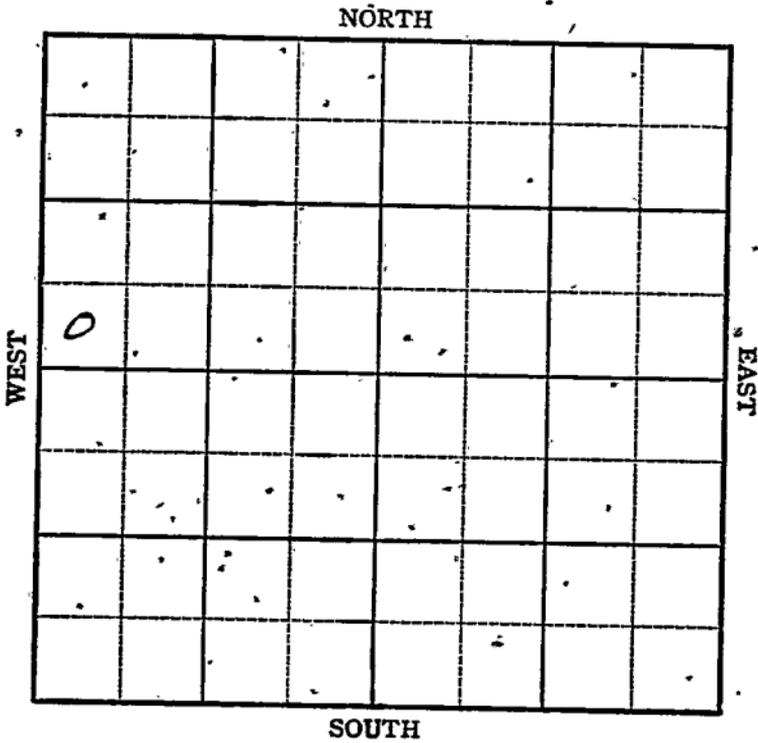

Sec. 23 Twp. 21 R. 12-W

Well No. #2 Maxwell Farm


Magnolia Company
Mueller

_____ Ft. from N. Line

330 Ft. from S. Line

_____ Ft. from E. Line

330 Ft. from W. Line

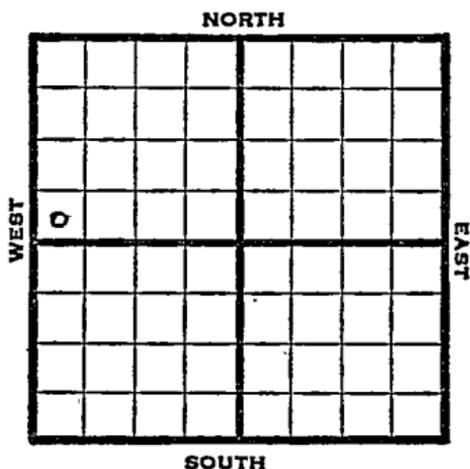

SW NW

1947 Elev. 1851' REPORT

5/14 Location

5/20 8" @ 291'
Drlg 1850'

5/27 Drlg 3300'

6/3 Lansing 3239
Viola 3521
Simpson 3540
Arbuckle 3596
TD 3605
5" @ 3594'
RUST

6/10 2000' acid
Drlg. 3695'

6/17 TD 3719' W
PB 3631'

6/24 5000 Acid.

7/1 " "

7/8 " "

7/16 Arbuckle 3596'
5" @ 3594'
7000 Acid.
Pump 5 oil / 89% W
Pot
Gr. 39
T. D. 3719'

Complete **COMPLETED**

Map No. 46 Sec. 23 Twp. 21 R. 12W

Well No. 2 Maxwell

Magnolia Company

FIRST REPORT Contractor

SW NW

SECTION PLAT

0			

_____ Ft. from N. Line

330 Ft. from S. Line

_____ Ft. from E. Line

330 Ft. from W. Line

Stafford County

Location X

Rig up _____

Drilling and Remarks:

RECORD

Cased _____ in., _____ ft.

Sand _____

Gas _____

Oil _____

Total Depth _____

PRODUCTION

1st 24 hrs. Nat. _____

1st 24 hrs. after shot _____

Gas _____ Cu. Ft.

Dry Hole _____

Abandoned _____

Date

MAY 14 1947 19 _____

S. J. LEWIS Scout

Map No. 46 Sec. 23 Twp. 21 R. 12W

Well No. 2 Maxwell

Magnolia Company

COMPLETE

Contractor

SWNW

E 11887

SECTION PLAT

_____ Ft. from N. Line

330 Ft. from S. Line

_____ Ft. from E. Line

330 Ft. from W. Line

Stafford County

Location _____

Rig up _____

Drilling and Remarks:

Ar 8096
5-11 @ 3094
7000 acid
Pump Oil + 89 1/2
BT
29° SW

RECORD

Cased _____ in, _____ ft.

Sand _____

Gas _____

Oil _____

Total Depth 3719

PRODUCTION

1st 24 hrs. Nat. _____

1st 24 hrs. after shot _____

Gas _____ Cu. Ft.

Dry Hole _____

Abandoned _____

Date

JUL 16 1947 19

S. J. LEWIS Scout