


Section 23 Township 21 Range 13W

Well No. #1 Hall

Company S. A. Springer

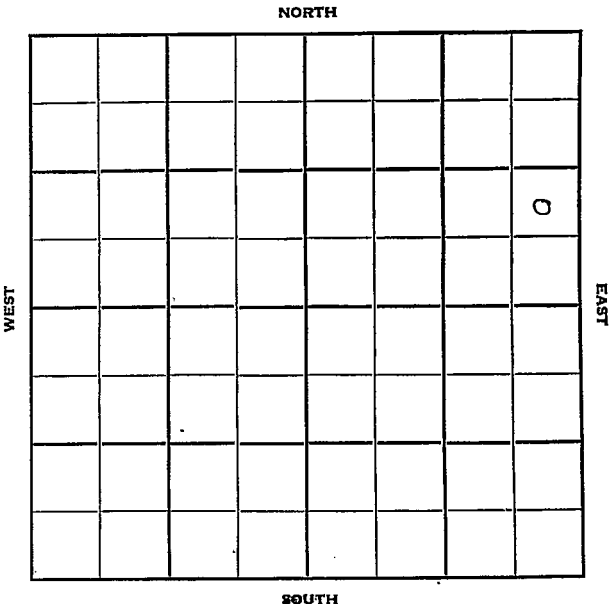

Sec. 23 Twp. 21 R. 13 W

Well No. # 1 Hall Farm

S. A. Springer Company

Wildcat Contractor

 Ft. from N. Line


990 Ft. from S. Line

330 Ft. from E. Line

 Ft. from W. Line

NE SE NE

Skelly & Mid-States DHM

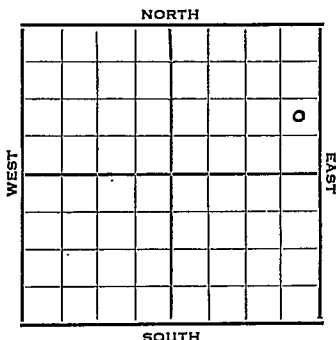

1951 Elev. 1868' REPORT

12/5 Spud 12-1-51
8" @ 288'
Anhy 720'
Drlg. 749'

1952
1/23 Spud 12-1-51
Oil Well TD 3620
8" @ 288 Anhy 720
Heeb. 3154 Br lime 3277
Lans. 3295
DST 3370-95 opn $\frac{1}{2}$ hr.
Rec. 220' Ocm 200' wtr.
DST 3452-85 opn 45 min. Rec. 130' ocm
Cong. 3529 Simp 3560
Arb. 3605 TD 3611
5" @ 3606 DD 3620
S/6 $\frac{1}{2}$ boph 1000 A S/10 boph
Comp. 140 bopd

COMPLETED

(Blk.)
(Twp.)

S. A. Springer

1 Farm Hall

1868	Location	NE	SE	NE
------	----------	----	----	----

0

COMPLETE

S Line NE

F Line	Quarter
--------	---------

1st. Report

JAN 23 1952

Wildcat

12-1-51

Oil well	TD 3620
----------	---------

8" @ 288 Anhy 720 Heeb. 3154

Br. lime 3277 Lans. 3295 DST 3370-95

open $\frac{1}{2}$ hr. Rec. "220' ocm 200' water

DST 3452-85 open 45 min. Rec. 130' ocm

Cong. 3529 Simp. 3560 Arb. 3605

TD 3611 5" @ 3606 DD. 3620

S/ $6\frac{1}{2}$ boph 1000 A S/ 10' boph

~~Comp. 140 bopd~~

J. G. McGEHEE