

Section 23 Township 21 Range 14-WWell No. #1 BordewickCompany Petroleum Inc.

NORTH

WEST

					0		

EAST

SOUTH

KANSAS

Stafford

Sec. 23 Twp. 21 R. 14-W

Well No. #1 Brodewick Farm

Petroleum Inc. Company

Derby Oil Contractor

Van Winkle

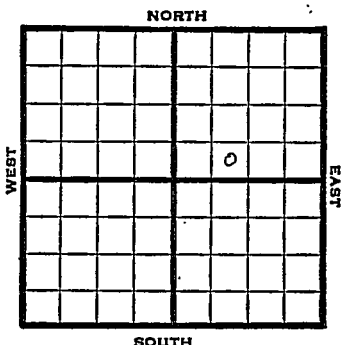
 Ft. from N. Line

330 Ft. from S. Line

 Ft. from E. Line

990 Ft. from W. Line

SE SW NE



1950 Elev 1931 REPORT

10/11 MIM

10/25 Spud 10-10-50

8" @ 237

Anhy 835

Heeb 3256

Br lime 3374

Lans 3386

DST 3390-3420 opn 1 hr rec 95' mud

DST 3490-3516 opn 1 hr rec 60' mud

DST 3566-93 opn 1 hr rec 30' mud

Viola 3640

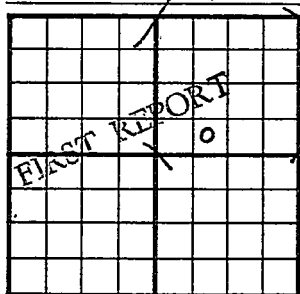
Simp 3684

Arb 3728

TD 3778

D&A

ABANDONED

County Stafford State KansasSec. 23 (Blk. Twp.) 21 (Sur. Rge.) 14W Map No.Operator Petroleum Inc.Well No. 1 Farm BordewickElev. Location SE SW NE330 Ft. From S Line NE990 Ft. From W Line Quarter1st. Report OCT 11 1950

Completion

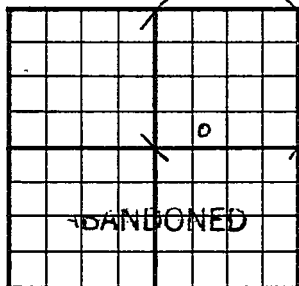
Remarks

Darby Oil - Contr.

Spudding Date

Drlg. Data Van Winkle PoolM T M

J. E. TYRA

County Stafford State KansasSec. 23 (Blk. 21) (Sur. 14W) Map No. 14WOperator Petroleum Inc.Well No. 1 Farm BordewickElev. 1931 Location SE SW NE330 Ft. From S Line NE990 Ft. From W Line Quarter1st. Report Completion OCT 25 1950Remarks Van Winkle PoolDarby Oil - Contr.Spudding Date 10-10-50Drlg. Data. D & A TD 37788" @ 237 Anhy 835 Heeb. 3256Br. lime 3374 Lans. 3386 DST 3390-3420open 1 hr. Rec. 95' mud DST 3490-3516open 1 hr. Rec. 60' mud DST 3566-93open 1 hr. Rec. 30' mud Viola 3640Simp. 3684 Arb. 3728 TD 3778D & A