


Section 23 Township 21 Range 14-WWell No. #1 Van WinkleCompany Davis-Childs & Sterling Drlg.

NORTH

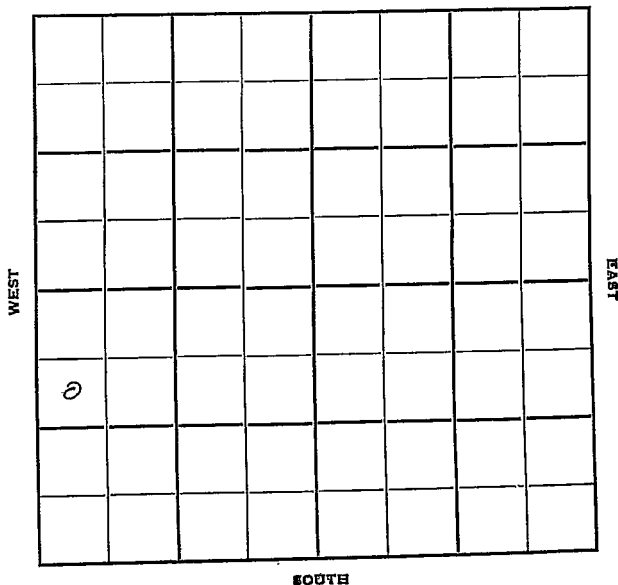

SOUTH

Stafford

KANSAS

Sec. 23 Twp. 21 R. 14W

Well No. #1 Van Winkle Farm

Davis-Childs & Sterling Company

Sterling Drlg. - Contr. Contractor

Van Winkle Pool


990' Ft. from N. Line

Ft. from S. Line

Ft. from E. Line

330' Ft. from W. Line

SW NW SW

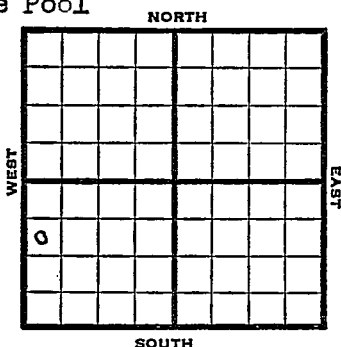

1950

Elev. 1934' REPORT

9/20

Cellar & Pits

10/18

Spud 9-25-50

D&A TD 3779'

8-5/8" @ 310'

Anhy 825' Heeb. 3280'

Br Lime 3398' Lans. 3408'

Stain 3572-78 3582-3600

Viola 3681' Simpl 3725'

Sd 3774' Arb. 3776'

TD 3779' 5" @ 3778'

10/3598-3606 Test SW SP 3590


24/3576-80 500 A FU 1200' wtr.

SP 2570 12/3559-64 FU 500' SW

D&A

ABANDONED

County Stafford State Kansas
 Sec. 23 (Blk.) 21 (Sur.) 14W Map No.
 Operator Davis-Childs & Sterling Drdg.
 Well No. 1 Farm Van Winkle
 Elev. Location SW NW SW

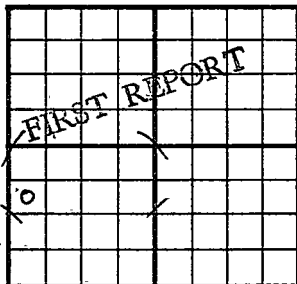


990 Ft. From N Line SW
330 Ft. From W Line Quarter
 1st. Report SEP 20 1950
 Completion
 Remarks
Phillips farmout
 Spudding Date

Drlg. Data Van Winkle Pool
Cellar & pits

J. E. TYRA

County Stafford State Kansas
 Sec. 23 (Blk. 21) (Sur. 14W) Map No.
 Operator Davis-Childs & Sterling Drlg.
 Well No. 1 Farm Van Winkle
 Elev. 1934 Location SW NW SW

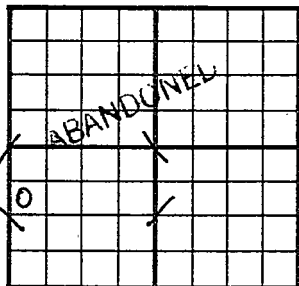

990 Ft. From N Line SW
330 Ft. From W Line Quarter
 Ist. Report
 Completion OCT 18 1950
 Remarks Van Winkle Pool
Sterling Drlg. - Contr.
 Spudding Date 9-25-50

Drlg. Data D & A TD 3779
8 5/8" @ 310 Anhy 825 Heeb. 3280
Br. lime 3398 Lans. 3408 Stain 3572-78
3582-3600 Viola 3681 Simp. 3725
Sd. 3774 Arb. 3776 TD 3779 5" @ 3778
10/ 3598-3606 Test sw. SP 3590
24/ 3576-80 500A FU 1200' water
SP 2570 12/ 3559-64 FU 500' sw
D & A

J. E. TYRA