

KANSAS

Rice


Form 51-5M-7-39-Palace

Section 23 Township 21 Range 7-W

Well No. #1 J. C. Steierl

Company Mid-Plains

NORTH Household Pool

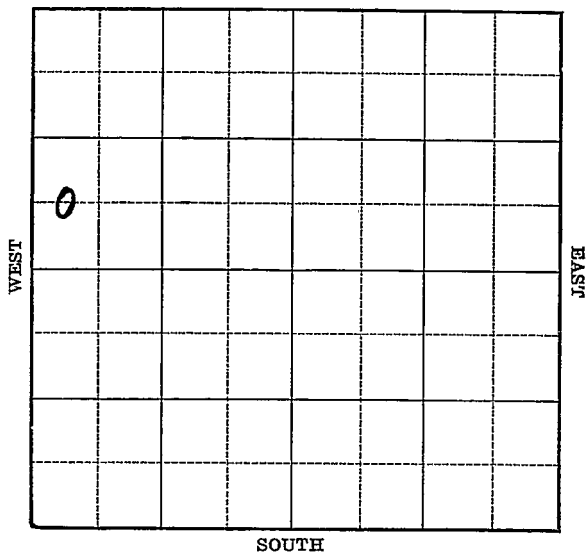

KANSAS

Rice

Sec. 23 Twp. 21 R. 7-W

Well No. #1 J. C. Steierl Farm

Mid-Plains

Company


(Hauschild)

Ft. from N. Line

660 Ft. from S. Line

Ft. from E. Line

330 Ft. from W. Line

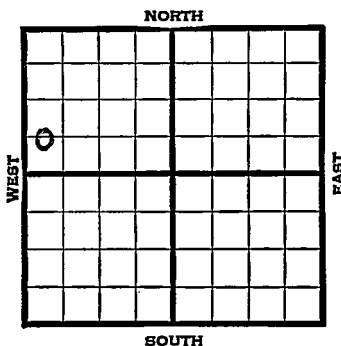[illegible]

KANSAS *Rice*Map No. *49* Sec. *23* Twp. *21* R. *7W*Well No. *1 J. C. Steier**Mid-Plains* Company

Contractor

C. W. L. BOYD

FIRST REPORT

SECTION PLAT

____ Ft. from N. Line

660 Ft. from S. Line

____ Ft. from E. Line

330 Ft. from W. Line

Haasschulz Pool.

Location _____

Rig up _____

Drilling and Remarks:

*10" @ 104**Dr 91478*

RECORD

Cased _____ in., _____ ft.

Sand _____

Gas _____

Oil _____

Total Depth _____

PRODUCTION

1st 24 hrs. Nat. _____

1st 24 hrs. after shot _____

Gas _____ Cu. Ft.

Dry Hole _____

Abandoned _____

Date

AUG 23 1939 19*S. J. LEWIS* Scout

Rice

KANSAS

Map No. _____ Sec. 23 Twp. 21 R. 7WWell No. 1 J. C. SteierlMid-Plains

Company _____

Contractor _____

COMPLETED**C W L SW NW**

_____ Ft. from N. Line

660

_____ Ft. from S. Line

_____ Ft. from E. Line

330

_____ Ft. from W. Line

HAUSCHILD POOL**SECTION PLAT**

Location _____

Rig up _____

Drilling and Remarks:

Cong 3385.
76 @ 3385

Pump 847

RECORD

Cased _____ in., _____ ft.

Sand _____

Gas _____

Oil _____

Total Depth 3392**PRODUCTION**

1st 24 hrs. Nat. _____

1st 24 hrs. after shot _____

Gas _____ Cu. Ft.

Dry Hole _____

Abandoned _____

Date

SEP 20 1939 19S. J. LEWIS

Scout