

Section 23 Township 21 Range 11 WWell No. # 1 FairCompany Shelly & Miller

NORTH

WEST								
								0

EAST

SOUTH

Stafford

KANSAS

Sec. 23 Twp. 21 R. 11 W

Well No. # 1 Fair Farm

Shelly & Miller Company

Shelly & Miller Contractor

Ft. from N. Line


330 Ft. from S. Line

330 Ft. from E. Line

Ft. from W. Line

SE SE SE

GSO - DHM

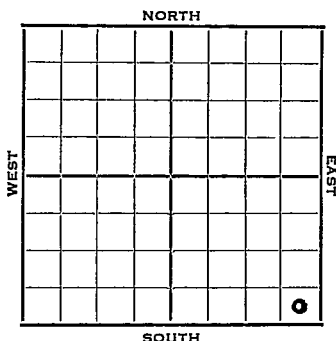

1952

Elev. 1741' REPORT

7/23

MIR

7/30

8" @ 194 Heeb. 2936 Br L1 3073

Lans. 3092'

Dr1g. 3120'

8/6

Spud 7-21-52

D & A TD 3530' 8" @ 194

Heeb 2936' Br. lime 3073' Lans. 3092'

Cong. 3380' Viola 3421' Simp. 3485'

Arb. 3500'

TD 3530' D & A

ABANDONED

County Stafford State Kansas

Sec. **23** (Blk. Twp.) **21** (Sur. Rge.) **11W** Map No.

Operator **Shelly & Miller**

Well No. **1** Farm **Fair**

Elev. 1741 Location SE SE SE

FIRST REPORT

330 Ft. From S Line SE

330 Ft. From E Line Quarter

1st. Report **JUL 23 1952**

Completion _____

Remarks CSO - DEIM

Shelly & Miller - Contr.

Spudding Date _____

Drlg. Data _____


County Stafford State Kansas

Sec.	23	(Blk. Twp.)	21	(Sur. Rge.)	11W	Map No.
------	----	----------------	----	----------------	-----	---------

Operator Shelly & Miller

Well No. 1 Farm Fair

Elev.	1741	Location	SE SE SE
-------	------	----------	----------

330 Ft. From S Line SE

330 Ft. From E Line Quarter

1st. Report

Completion AUG 6 1952

Remarks

Shelly & Miller - Contr.

Spudding Date 7-21-52

Drlg. Data D & A TD 3530

8" @.194 Heeb. 2936 Br. lime 3073

Lans. 3092 Cong. 3380 Viola 3421

Simp. 3485 Arb. 3500 TD 3530

D & A