


Section 23 Township 21 Range 16W

Well No. 1 Fox

Company Westpan Hydrocarbon

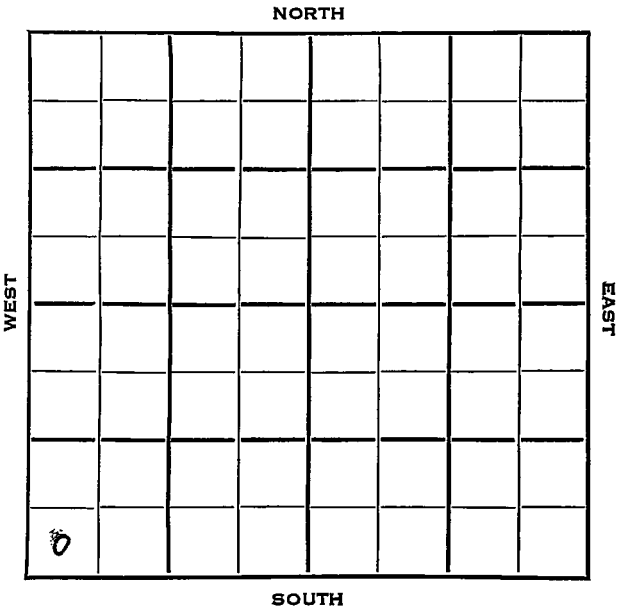

Pawnee

SEC.	TWP.	R.
23	21	16W ✓

WELL NO.

#1 Fox

FARM

COMPANY

Westpan Hydrocarbon

CONTRACTOR

Hilton Drlg.

Larned Pool

NORTH

Ft. from N. Line

330

Ft. from S. Line

Ft. from E. Line

330

Ft. from W. Line

WEST

EAST

SOUTH

SW SW SW

1953	ELEVATION 1978'	REPORT
11/4	Spud 10-31-53 8" @ 986' Anhy 977' Drlg 1140'	
11/11	Heeb 3375', Tor 3395', Doug 3410', Br. L. 3472', Lans 3484' Drlg 3590'	
11/18	Cong 3749', V 3755' DST 3754-85', 1 hr., 20' M Simp 3797', Arb. 3855' RTD 3859' Schl 5" @ 3856'	
1954 1/13	Spud 10-31-53 Oil well TD 3860' 8" @ 986 Anhy 977' Heeb 3375 Tor. 3395' Doug. 3410' Br lime 3472' Lans. 3484' Cong. 3749' Viola 3755 DST 3754-85 open 1 hr rec 20' mud Simp. 3797' Arb. 3855 TD 3859' 5" @ 3856 DD 3860 S/60 BO 6 hr. S/50 BO 4 hr. P/67 BO 5 hr. P/111 BO 8½ hr. 500 A Comp. 1322 BOPD 6% wtr.	

COMPLETED

J. G. McGEHEE