


SECTION 23 TOWNSHIP 21S RANGE 34W

WELL NO. #1 McHugh

COMPANY Bruce Anderson (Denver, Colo)

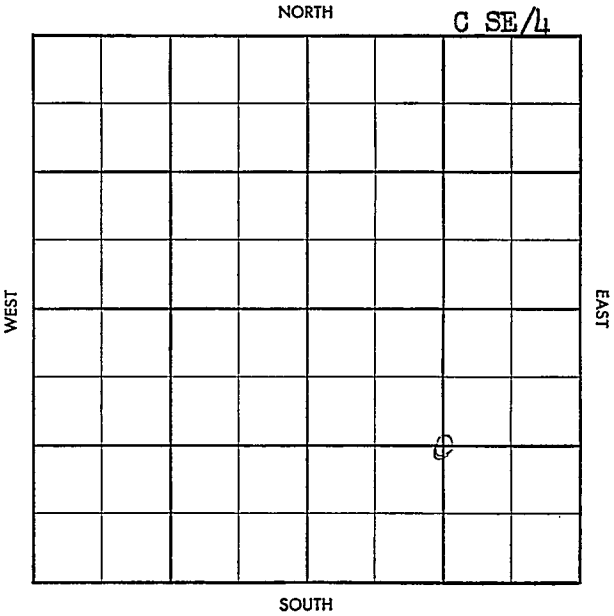

~~W. Anderson~~
~~McHugh~~

County Finney Elev. _____
 Sec. 23 Twp. 21 Rge. 3/W
 Company Bruce Anderson (Denver, Colo.)
 Farm Name McHugh No. 1

TOPS	DEPTH	LOG	DATUM
Anh.			
Tp.			
H.			
Tr.			
Dg.			
B. L.			
L.			
K.C.			
B.K.C.			
Ce.			
C.			
M.			
M.			
K.			
Mz.			
Mq.			
V.			
S.			
S.			
A.			
R.			
Pf.			
G.			
T.D.			

Loc. in Sec. C SE/4

Geol. _____
 Contr. _____
G-M #6

Pool _____
Hugoton

FIRST REPORT	
2	0
JUL 30 58	

Date Comm. 7-25-58
8" @ 306 w/150 RTD 2590; 5" @ 2555 w/100
WOCT

Co.

Lse.

No.

Sec.

T.

R.

Twp. No Pool No
 Sec. No Face No

SR-513-B

County Finney Elev. 2937 DF
 Sec. 23 Twp. 21 Rge. 31 W
 Company Bruce Anderson (Denver, Colo.)
 Farm Name Church No. 1

TOPS	DEPTH	LOG	DATUM
Anh. <u>None</u>	<u>2550</u>		
Tp.			
H.			
Tr.			
Dg.			
B.L.			
L.			
K.C.			
B.K.C.			
Ce.			
C.			
M.			
M.			
K.			
Mz.			
Mg.			
V.			
S.			
S.			
A.			
R.			
Pf.			
G.			
T.D.	<u>2590</u>		

Loc. in Sec. G SE 1/4

Geol. _____
 Contr. _____
G-16
 Pool _____
Haroton

COMPLETE
 AUG 13 58

Date Comm. 7-25-58
 BH # 306 W/150 RTD 2590; 5" " 2555 W/100

TRGT AUG 6 58 M1 AUG 13 58 CO 2590
ga 360 MCF dry frac 10x10
2000 B/l down 2.250 MCF
Thru CSG SIP 379.6

Co. _____
 Lsq. _____
 No. _____
 Sec. _____
 T. _____
 R. _____