


KANSAS GEOLOGICAL SOCIETY
508 East Murdock
Wichita, Kansas

API# 15-083-20,223

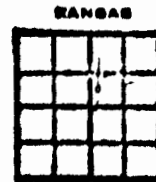


5-21-2400
w/2 SW NE

DEC 1 1972

KANSAS CORPORATION COMMISSION

WELL RECORD

(Mail to Kansas Geological Survey, 4150 Monroe Street, Wichita, Kansas 67209)

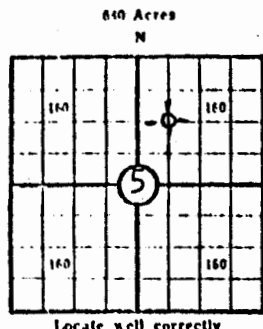

Lease Name: HUMBURG RANCH Well No. 1
Well Located: C W/2 SW NE
SEC 5 TWP 21S RGE 24W
Operator: DANE G HANSEN TRUST
Address: LOGAN, KANSAS
Elevation: Ground D.F. K.B. 2306 KB
Type Well: (Oil, gas, dry hole) OIL

Drilling Commenced: MAY 22 1972 Drilling Completed: JUNE 1 1972
Well Completed: 1972 Total Depth 4443'
Initial Production:

Casing Record

Size: 8 5/8" Set at 366.11' Size: Set at
Size: Set at Size: Set at

Liner Record

Size: Set from To


Cementing

Casing Size	Sacks	Type Cement and Additives
<u>8-5/8</u>	<u>225</u>	<u>POZMIX (60-40) 3% C C</u>
<u> </u>	<u> </u>	<u> </u>
<u> </u>	<u> </u>	<u> </u>

Perforations

Formation	Perforated Interval and Number Shots
<u> </u>	<u> </u>
<u> </u>	<u> </u>
<u> </u>	<u> </u>
<u> </u>	<u> </u>

Electric Log Run (Show type log and depths covered)

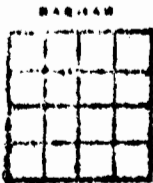

5-21-24W
W/2 SWNE

FORMATION, TESTING AND COMPLETION RECORD

Show Drill Stem Tests,
Well Stimulation and
Production Tests

Formation	Top	Bottom
SHALE	0	835
SHALE & SAND	835	1530
ANHYDRITE	1530	1575
SHALE & RED BED	1575	1815
SHALE	1815	2060
SHALE & LIME	2060	2700
LIME	2700	2840
LIME & SHALE	2840	3100
SHALE	3100	3215
SHALE & LIME	3215	3415
SHALE	3415	3595
SHALE & LIME	3595	3795
LIME	3795	4406
MISSISSIPPIAN	4406	4433
RTD		4433

DST #1 4294'-4315'
DST #2 4409'-4433'
DST #3 4426'-4443'

Smp Tops
Anhy 1530
Theeb 3723
Tot 3746
LKC 3772
BKC 4132
Marm 4160
Ft Sc 4303
B P Cong 4382
Miss 4401
Rdt 4443

