


KANSAS CORPORATION COMMISSION

WELL RECORD

26-21-24W

(Mail to Kansas Geological Survey, 4150 Monroe Street, Wichita, Kansas 67209)

API # 15-083-20,221

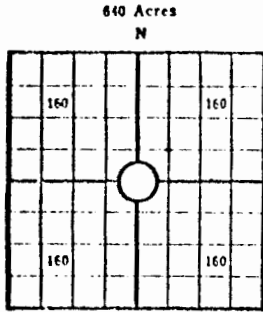

Locate well correctly

Lease Name: Goebel "J" Well No. 1

Well Located: C SW NE
Hodgeman SEC 26 TWP 21S RGE 24W

Operator: Pickrett Drilling Company

Address: 705 Fourth National Bank Bldg., Wichita, Kansas

Elevation: Ground 2414' D.F. 2416' K.B. 2419'

Type Well: (Oil, gas, dry hole) Dry Hole

Drilling Commenced: 4/12/ 1972 Drilling Completed: 4/23/ 1972

Well Completed: 19 Total Depth 4625'

Initial Production: _____

Casing Record

Size: 8-5/8" Set at 246' Size: _____ Set at _____

Size: _____ Set at _____ Size: _____ Set at _____

Liner Record

Size: _____ Set from _____ To _____

Cementing

Casing Size	Sacks	Type Cement and Additives
<u>8-5/8"</u>	<u>150 sacks</u>	<u>3/2</u>
_____	_____	_____
_____	_____	_____



Perforations

Formation	Perforated Interval and Number Shots
_____	_____
_____	_____
_____	_____
_____	_____

Electric Log Run (Show type log and depths covered)

Electra, Inc. - Radiation Accurlog, Sonic Velocity

FORMATION, TESTING AND COMPLETION RECORD

Pickrell Drilling Co.

26-21-24W

Goebel "A" #1

Show Drill Stem Tests,
Well Stimulation and
Production Tests

Formation	Top	Bottom	
Sandy Clay	0	100	DST # 1 4468-4500: Open 15" SI 30" Open 30" SI 30"
Shale Hard Sand	100	248	Weak blow 7 mins, rec. 10' mud. BHP 59-30
Shale	248	750	FP 11-11 and 23-23.
Red Beds - Shale	750	970	DST # 2 4573-90: 4573-90 Open 15" SI 30" Open 30"
Shale & Red Beds	970	1035	SI 30", weak blow 10" rec. 3' mud. BHP 4-4, FP 0-0.
Blaine	1035	1055	DST # 3 4590-4600: Open 15" SI 30" Open 120"
Shale	1055	1120	SI 60" Good blow blow rec. 250' gas in pipe+ 90'
Sand	1120	1330	clean oil + 30' muddy oil + 130' heavy oil cut mud.
Shale & Shells	1330	1655	BHP 1120-983, FP 44-50 and 66-122.
Shale	1655	1680	DST # 4 4600-10 Open 15" SI 30" Open 30" SI 30".
Anhydrite	1680	1705	Weak blow 15" rec. 15' thin mud. BHP 1002-769
Shale	1705	2260	FP 11-11 and 11-11.
Shale - Lime	2260	2365	DST # 5 4610-4625: Open 15 mins, tool wouldn't
Lime & Shale	2365	2720	rotate. IBHP 1366, rec. 120' muddy water.
Lime	2720	2985	
Lime & Shale	2985	3760	
Shale & Lime	3760	3980	
Li'	3980	4600	
Mississippi	4600	4610	
Lime, RTD	4610	4625	

