


Section 24 Township 21 Range 13 W

Well No. #1 Brand

Company Francis Oil & Gas

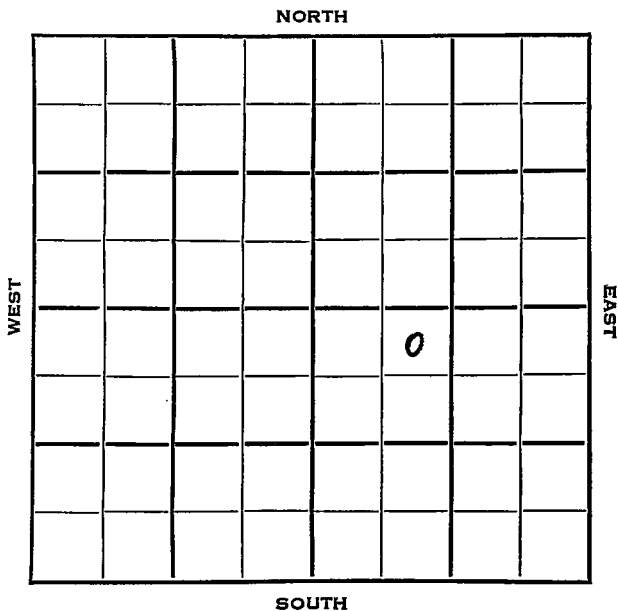

**Stafford KANSAS**

SEC.  24	TWP.  21	R.  13 W
----------------	----------------	----------------

WELL NO. \_\_\_\_\_

COMPANY # 1 Brand \_\_\_\_\_ FARM


CONTRACTOR Francis Oil & Gas \_\_\_\_\_

330 Hazel Pool \_\_\_\_\_ Ft. from N. Line

\_\_\_\_\_ Ft. from S. Line

\_\_\_\_\_ Ft. from E. Line

990 \_\_\_\_\_ Ft. from W. Line

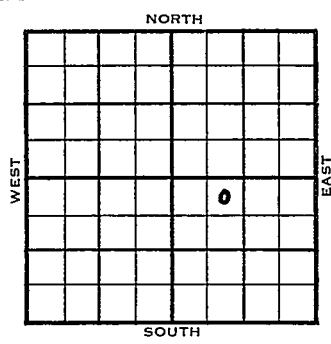

NE NW SE

1953	ELEVATION	REPORT
------	-----------	--------

10/28	Location
11/4	"
11/11	"
11/18	8" @ 291' Anhy 715' Drlg. 3190'
11/24	Spud 11-11-53 D & A TD 3700 8" @ 291 Anhy 715 Heeb 3158 Br lime 3288 Lans 3304 Cong 3530 Viola 3598 Simp sh. 3612' EroArb. 3632' DST 3634-52 open 1 hr rec 10' mud Off Arb. 3671 DST 3658-78 open 1 hr rec 30' drlg. mud 775# TD 3700 D & A

**ABANDONED**

County Stafford State Kansas

Sec. 24 (Blk. Twp.) 21 (Sur. Rge.) 13W Map No.

Operator Francis Oil & Gas

Well No. 1 Farm Brand

Elev. \_\_\_\_\_ Location NE NW SE


330 Ft. From N Line SE

990 Ft. From W Line Quarter

1st. Report OCT 28 1953

Completion \_\_\_\_\_

Remarks \_\_\_\_\_

Spudding Date \_\_\_\_\_

Drig. Data Hazel Pool

Location

