


Section 24 Township 21 Range 13W

Well No. 1 Senmailian

Company Pam-Kar

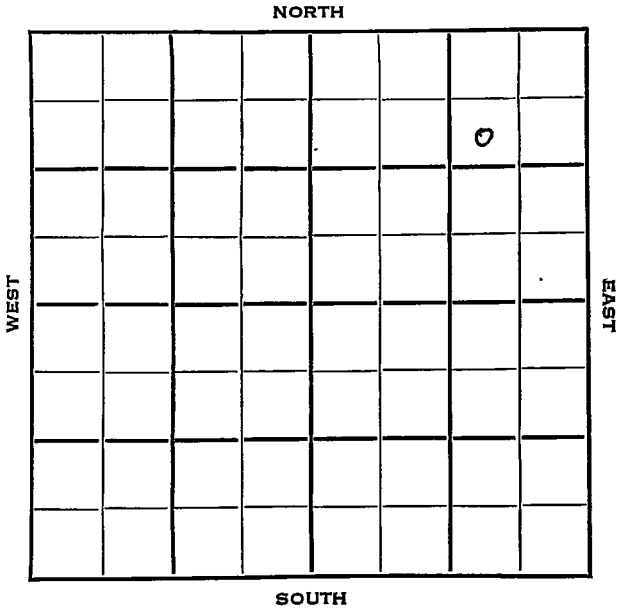

Stafford KANSAS


SEC. 24	TWP. 21	R. 13W ✓
-------------------	-------------------	--------------------

WELL NO. **1 Senmailian** FARM

COMPANY **Pam-Kar**

CONTRACTOR **Pam-Kar**

990 _____ Ft. from N. Line
 _____ Ft. from S. Line
990 _____ Ft. from E. Line
 _____ Ft. from W. Line

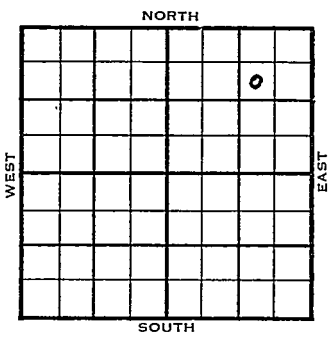

SW NE NE

1954	ELEVATION 1869'	REPORT
-------------	---------------------------	--------

1/6 Spud 1-1-54
 8" @ 270'
 Drlg. 1700'

1/13 Br. L. 3273', Lans 3290', Arb 3586'
 TD 3595'
 5" @ 3588'

1/20 DD 3635' FU 700' oil 12 hrs.

1/27 1000A, S/10 boph 4 hrs., POP

2/10 Spud 1-1-54
 Oil Well
 TD 3635'
 8" @ 270'
 Heeb 3146', Br. Lime 3273', Lans
 3290', Arb 3586'
 TD 3595'
 5" @ 3588'
 DD 3635' FU 700' oil 12hr.
 1000 A S/ 10 boph 4 hr.
 Comp 336 bopd.

COMPLETED

