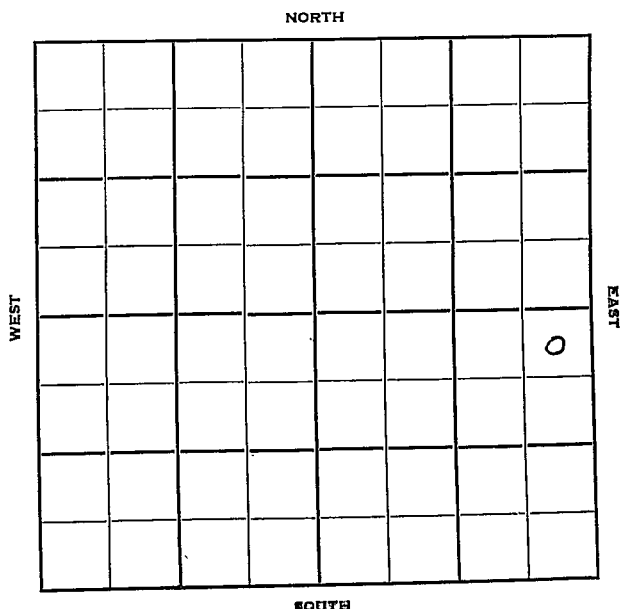


Section 24 Township 21 Range 14WWell No. #1 FosterCompany Stanolind

Sec. 24 Twp. 21 R. 14W ✓

Well No. #1 Foster Farm

Stanolind Company

Noble Drlg. - Contr. Contractor

Pundsack Pool


330' Ft. from N. Line

_____ Ft. from S. Line

330' Ft. from E. Line

_____ Ft. from W. Line

NE NE SE

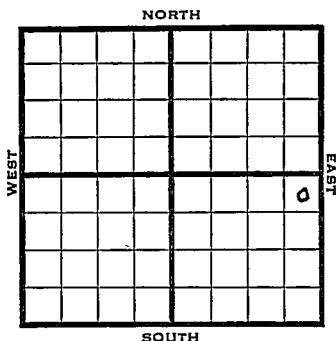

1950 Elev. 1928' REPORT

9/13 Location

11/8 Spud 9-13-50 Oil Well TD 3733'
Anhy 812' 8" @ 823' Lans. 3371'
SO 3395-98 3405-10 3418-22
DST 3393-3428 opn ½ hr Rec. 75' O&GCM
DST 3495-3529 opn 1 hr Rec. 310' OCM
DST 3536-79 opn 45 min Rec. 12' mud
Cong. 3621' Viola 3626' Simp 3667'
AArb. 3721-25'
DST 3722-25 opn 1 hr Rec. 52' muddy
wtr. tr of oil
5½" @ 3722 TD 3733 S/18 BWPB
PB 3716 14/3555-59 24/3544-50
1000 A S/½ BO 1 BWPB 2000 A
S/10 BOPB SP 3536 40/3512-22
S/10 BOPB 2000 A S/14 BOPB
S/12 BOPB Comp. 118 BOPD 27% wtr.

COMPLETED

County Stafford State Kansas
 Sec. 24 (Blk. 21) (Sur. 14W) Map No.

Operator Stanolind

Well No. 1 Farm Foster

Elev. 1928 Location NE NE SE

FIRST REPORT

330 Ft. From N Line SE

330 Ft. From E Line Quarter

1st. Report SEP 13 1950

Completion

Remarks

Phillips farmout

Spudding Date


Drlg. Data

Pundsack Pool

Location

J. E. TYRA

County Stafford State Kansas
 Sec. 24 (Blk.) 21 (Sur.) 14W Map No.
 Operator Stanolind
 Well No. 1 Farm Foster
 Elev. 1928 Location NE NE SE

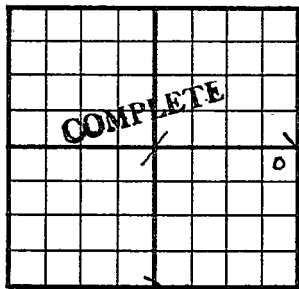

330 Ft. From N Line SE
330 Ft. From E Line Quarter
 1st. Report
 Completion Nov 8 1950
 Remarks Pundsack Pool
Noble Drlg. - Contr.
 Spudding Date 9-13-50

Drlg. Data Oil well TD 3733
Anhy 812 8" @ 823 Lans. 3371
S0 3395-98 3405-10 3418-22 DST 3393-
3428 open $\frac{1}{2}$ hr. Rec. 75' o & gcm
DST 3495-3529 open 1 hr. Rec. 310' ocm
DST 3536-79 open 45 min. Rec. 12' mud
Cong. 3621 Viola 3626 Simp. 3667
Arb. 3721-25 DST 3722-25 open 1 hr.
Rec. 52' muddy water tr of oil
 $5\frac{1}{2}$ " @ 3722 TD 3733 S/ 18 bwph PB 3716
14/ 3555-59 24/ 3544-50 1000 A
S/ 1/4 bo 1 bwph 2000 A S/ 10 boph
SP 3536 40/ 3512-22 S/ 10 boph
2000 A S/ 14 boph S/ 12 boph
Comp. 118 bopd 27% water

J. E. TYRA