

Section 24 Township 21 Range 16W

Well No. 1 Hagen

Company Magnolia

No Name

NORTH

							0

WEST

EAST

SOUTH

KANSAS Pawnee

Sec. 24 Twp. 21 R. 16W

Well No. #1 Hagen Farm

Magnolia Company

No Name

Ft. from N. Line

330


Ft. from S. Line

330

Ft. from E. Line

Ft. from W. Line

SE/c

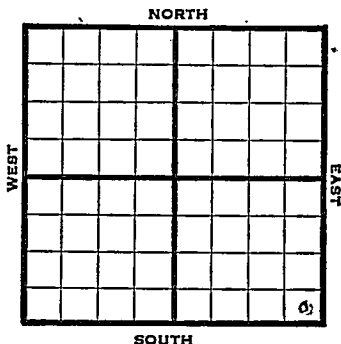

1947

Elev. 1960' REPORT

10/22

Location

10/29

8" @ 931'

WOC

11/5

Drlg. 3375'

11/12

Brown Line 3458'

Lansing 3469'

Viola 3748'

Simpson 3805'

Arbuckle 3856'

TD 3897'

11/19

Arb. 3856'

TD 3897'

ED

ABANDONED

Map No. _____ Sec. 24 Twp. 21 R. 16W

Well No. 1 Hagen

Magnolia _____ Company

FIRST REPORT _____ Contractor

SE/C


SECTION PLAT

_____ Ft. from N. Line

330 Ft. from S. Line

330 Ft. from E. Line

_____ Ft. from W. Line

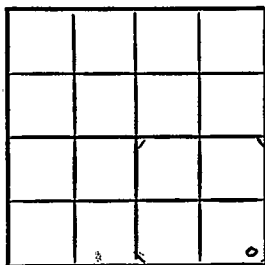

Pawnee County

Location X

Rig up _____

Drilling and Remarks:

RECORD

Cased _____ in., _____ ft.

Sand _____

Gas _____

Oil _____

Total Depth _____

PRODUCTION

1st 24 hrs. Nat. _____

1st 24 hrs. after shot _____

Gas _____ Cu. Ft.

Dry Hole _____

Abandoned _____

Date

OCT 22 1947 19

S. J. LEWIS Scout

