

# Pawnee

DX 78-1

KANSAS

Section 24 Township 21 Range 16W

Well No. #1 Schnack

Company Nadel & Gussman

NORTH

WEST

EAST

|  |  |  |  |  |  |  |   |
|--|--|--|--|--|--|--|---|
|  |  |  |  |  |  |  |   |
|  |  |  |  |  |  |  | 0 |
|  |  |  |  |  |  |  |   |
|  |  |  |  |  |  |  |   |
SOUTH

**KANSAS**

|                 |      |      |
|-----------------|------|------|
| SEC.            | TWP. | R.   |
| 24              | 21   | 16 W |
| WELL NO.        |      |      |
| # 1 Schnack     |      |      |
| COMPANY         |      | FARM |
| Nadel & Gussman |      |      |
| CONTRACTOR      |      |      |
| Reserve         |      |      |


990 \_\_\_\_\_ Ft. from N. Line

Ft. from S. Line

330 \_\_\_\_\_ Ft. from E. Line

\_\_\_\_\_ Ft. from W. Line

SE NE NE

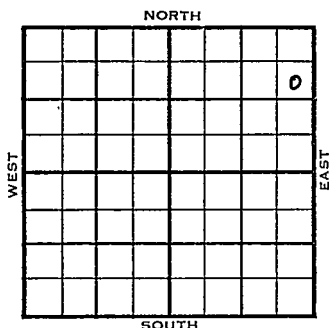

| ELEVATION |          | REPORT   |
|-----------|----------|----------|
| 1954      | 1976' DF | 1979' RB |

9/15  
11/10

Location  
Spud 9-12-54  
OilWell  
TD 3900'  
8-5/8" @ 960'  
Heeb 3345'; Br. Lime 3444' Lans 3453'  
B KC 3666', Cong 3728' Viola 3737'  
Simp 3768' Arb 3823'  
DST 3825'-35' opn 45 min, gas in 2 min  
3,115,000 cfg. 1170#  
DST 3846'-61' opn 45 min, gas in 2 min  
F. ocm in 20 min rec 1980' oil, 120'  
wtr. 1190#  
TD 3900'  
5" @ 3899'  
23/ 3850-54 S/ 3.75 boph 8 hr.  
250 A F/ 10 bfph 60% Wtr. 8 hr.  
Comp F/ 25 bopd. 25% Wtr. 1,000,000  
cfg.

**COMPLETED**



FABEN GILSTRAP