



LOT FILE

Pawnee

KANSAS

SEC. 1	24	TAMP.	21	R.	16 W
--------	----	-------	----	----	------


WELL NO. # 1 Unruh - FARM

COMPANY F. B. Anschutz

CONTRACTOR Co. tools

Semi-Wildcat

\_\_\_\_\_ Ft. from N. Line  
 \_\_\_\_\_ Ft. from S. Line  
 \_\_\_\_\_ Ft. from E. Line  
 \_\_\_\_\_ Ft. from W. Line

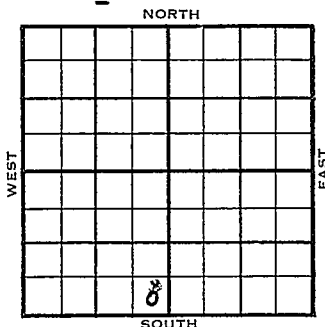

SE SE SW

1/2 mi. Sunray Mid-Continent

1955	ELEVATION		REPORT
	1970'		
9/7	MIR		
9-8	"		
9-15	Spud 9-6-55 8 5/8" @ 952/475 Drlg. 2771		
9-22	Tops: Anhy. 943, Heeb. 3349, Br.Ls. 3449, K.C. 3457 BKC 3671 Congl. 3725 Arb. 3834 DST 3543-55 op 30" rec. 840' sw, BHP 1120# 20"; DST 3846-57 op. 1 hr. gas in 2", ga. 1,630,000 cfg in 10", sp oil in 19", rec. 405' gassy oil plus 510' sulf wtr. BHP 1160# 30"; drlg. ahead.		
9/28	Comm 9-6-55 8 5/8" @ 952/475 Anh 943 H 3349 Bl 3449 Kc 3457 BKC 3671 C 3725 A 3834 TD 3897		

OVER

1955

9/28 DST 3543-55 open 1/2 hr. Rec 840'  
sw 1120/20" DST 3846-57 open 1 hr  
gas in 2 min. 1,630 mcfg. 10 min.  
Rec 405' gassy oil 510' sul wtr.  
1160/30" 5 1/2" @ 3890/160.  
6/3847-48 6 mcfg 6/3851-52 8 mcfgpd  
Comp shut in gas well

**COMPLETED**

ix



County Paynee Elev. 1970  
 Sec. 21 Twp. 21 Rge. 16W  
 Company F. B. Anschutz  
 Farm Name Unruh No. 1

TOPS	DEPTH	LOG	DATUM	Loc. in Sec.
Anh.	<u>943</u>			SE SE SW
Tr.				
H.	<u>3349</u>		<u>1379</u>	
Tr.				
Dg.				
BL.	<u>3449</u>		<u>1479</u>	
L.				
K.C.	<u>3457</u>		<u>1487</u>	Geol. _____
B.K.C.	<u>3674</u>		<u>1704</u>	Contr. _____
Ce.				
C.	<u>3725</u>		<u>1755</u>	Co. tools _____
M.				
M.				Pool _____
K.				
Mz.				Semi Wildcat
Ma.				
V.				
S.				
S.				
A.	<u>3834</u>		<u>1864</u>	COMPLETE
R.				
PE.				
G.				
TR.	<u>3897</u>			

Date Comm. 9-6-55 SEP 28 1955  
 8 5/8" @ 952/175-- DST 3513-55 open  
 1/2 hr. Rec. 840' sw 1120/20"  
 DST 3816-57 open 1 hr. gas in 2 min.  
 1,630 mcfg 10 min. Rec. 1105' gassy  
 oil 510' sul. wtr. 1160/30"  
 5 1/2" @ 3890/160 6/ 3817-48 6 mcfg  
 6/ 3851-52 8 mcfgpd Comp. shut in gas  
 well