

Finney


KANSAS

SECTION 24 TOWNSHIP 21S RANGE 34W

WELL NO. #1 Mos

COMPANY Petroleum Inc.

NORTH # C SW

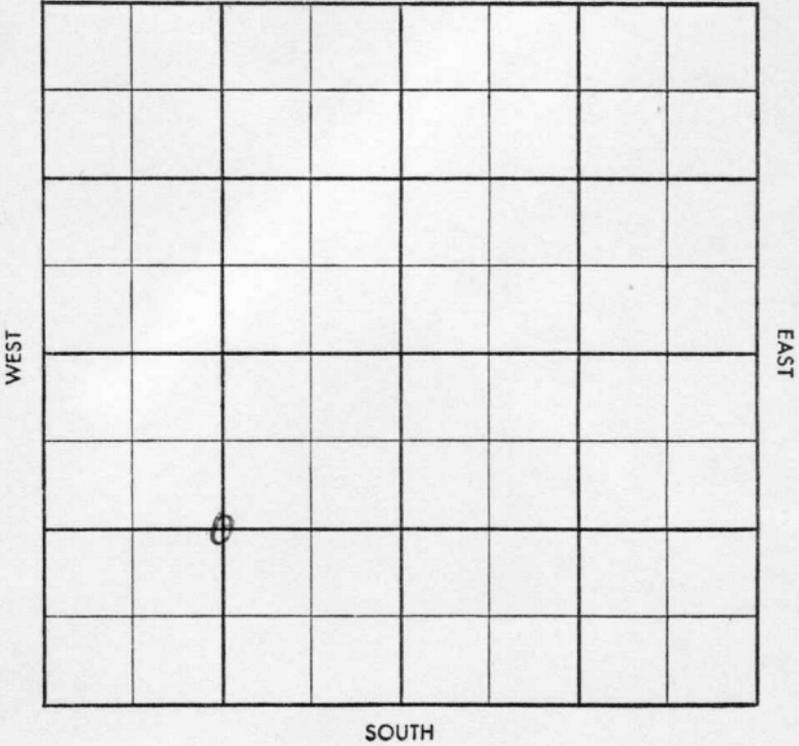

~~Twp. 21 N~~ ~~Pool 34 W~~  
~~Ob. 24 S~~ ~~Facet 21 N~~

S-513-B

County Finney Elev. \_\_\_\_\_  
 Sec. 24 Twp. 21 Rge. 34W  
 Company Petroleum Inc.  
 Farm Name Mos No. 1

TOPS	DEPTH	LOG	DATUM
Anh.			
Tp.			
H.			
Tr.			
Dg.			
B.L.			
L.			
K.C.			
B.K.C.			
Ce.			
C.			
M.			
M.			
K.			
Mz.			
Mq.			
V.			
S.			
S.			
A.			
R.			
Pf.			
G.			
T.D.	<u>2612</u>		

Loc. in Sec. \_\_\_\_\_  
C SW  
1250' SL  
1320' WL  
 Geol. \_\_\_\_\_  
 Contr. \_\_\_\_\_  
Co. tools  
 Pool \_\_\_\_\_  
Hugoton



Date Comm. 6-12-58  
8 5/8" @ 276/125 DST 2537-75  
open 4 1/2" gas in 4" ga. 519 MCG/30"  
520/20" 30' gcm 500/20" 5 1/2" @

Co. \_\_\_\_\_  
Lse. \_\_\_\_\_  
No. \_\_\_\_\_  
Sec. \_\_\_\_\_  
T. \_\_\_\_\_  
N. \_\_\_\_\_

Twp. X Pool X  
 Co. X Facet X

S-513-B

County Finney Elev. 2923 DF 2226 RB  
 Sec. 24 Twp. 21 Rge. 34W  
 Company Petroleum Inc.  
 Farm Name Mos No. 1

TOPS	DEPTH	LOG	DATUM
Anh. <u>Hel</u>		<u>2514</u>	
Tp. <u>Kuid</u>		<u>2532</u>	
H. <u>win</u>		<u>2598</u>	
Tr.			
Dg.			
B.L.			
L.			
K.C.			
B.K.C.			
Ce.			
C.			
M.			
M.			
K.			
Mz.			
Mq.			
V.			
S.			
S.			
A.			
R.			
Pf.			
G.			
T.D.	<u>2612</u>		

Loc. in Sec. C SW  
1250' SL  
1320' WL  
 Geol. \_\_\_\_\_  
 Contr. \_\_\_\_\_  
Co. tools  
 Pool \_\_\_\_\_  
Hugoton  
 COMPLETE  
 JUL 30 58

Date Comm. 6-12-58  
8 5/8" @ 276/125 DST 2537-75  
open 4 5/8" gas in 4" ga. 519 MCG/30"  
520/20" 30' gam 500/20" 5 1/2" @ 2610/90  
 JUN 25 '58 JUL 2 '58 JUL 9 '58 Co 2600  
~~gas in 4" ga. 519 MCG/30"~~ JUL 18 '58  
SQ 2588-92 75/ 2547-72 frac  
20x15 ga 4.000 mcf +15g  
wph JUL 23 '58 JUL 30 '58 4 mcf +15g  
wph SI P 410

Co. \_\_\_\_\_  
 Lse. \_\_\_\_\_  
 No. \_\_\_\_\_  
 Sec. \_\_\_\_\_  
 T. \_\_\_\_\_