


KANSAS CORPORATION COMMISSION

WELL RECORD

35-21-25W

(Mail to Kansas Geological Survey, 4150 Monroe Street, Wichita, Kansas 67209)

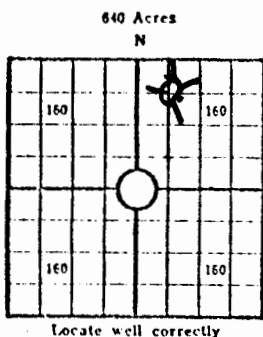

API #15-083-20,222

Lease Name: Burge "A" Well No. 1 L
 Well Located: C NW NE
Hodgeman SEC 35 TWP 21S RGE 25W
 Operator: Pickrell Drilling Company
 Address: 705 Fourth National Bank Bldg., Wichita, Kansas
 Elevation: Ground 2459' D.F. 2461' K.B. 2464'
 Type Well: (Oil, gas, dry hole) Dry Hole

Drilling Commenced: 4/24/ 1972 Drilling Completed: 5/4/ 1972
 Well Completed: 19 Total Depth 4610'
 Initial Production: _____

Casing Record

Size: 8-5/8" Set at 251' Size: _____ Set at _____
 Size: _____ Set at _____ Size: _____ Set at _____

Liner Rec Run 6 Jts. 8-5/8" surface casing set @ 251' KB. Cemented
w/150 sacks. Completed 6:30 P.M. Circulated.
 Size: No oil string run. D & A, Plugged 9:15 P.M. May 4, 1972.

Cementing

Casing Size	Sacks	Type Cement and Additives
<u>8-5/8"</u>	<u>150</u>	<u>3/2 Cement</u>
_____	_____	_____
_____	_____	_____

Perforations

Formation	Perforated Interval and Number Shots
_____	_____
_____	_____
_____	_____

Electric Log Run (Show type log and depths covered)Electra - Gamma-Neutron-Guard

35-21-25w

FORMATION, TESTING AND COMPLETION RECORD


Show Drill Stem Tests,
Well Stimulation and
Production Tests

Formation	Top	Bottom
Sandy Soil	0	70
Hard Sand, Shale & Shells	70	254
Shale	254	395
Sand	395	520
Shale & Red Beds	520	865
Red Beds	865	1035
Blain	1035	1110
Shale - Red Beds	1110	1280
Sand	1280	1485
Red Beds	1485	1681
Anhydrite	1681	1719
Shale & Shells	1719	2067
Shale	2067	2200
Shale & Lime	2200	2370
Lime & Shale	2370	2695
Lime	2695	3590
Lime & Shale	3590	3745
Shale & Lime	3745	3910
Lime	3910	4545
Lime & Chert	4545	4595
Miss., RTD	4595	4610

DST # 1 4516-4600: Open 20" SI 30" Open 30" SI 30"
weak blow 20 min, rec. 15' mud w/oil spots.
IF 30-23#, FF 23-30#, IBHP 560#, FBHP 143#.
DST # 2 4592-4610: Open 20" SI 30" Open 120" SI 60"
Good blow, rec. 630' salt water. IF 35-71#, FF
101-298#, IBHP 1117#, FBHP 1036#.

C.F.S.
4600
4610

Slope Tests
2000
2500
3000
3500
4000
4500

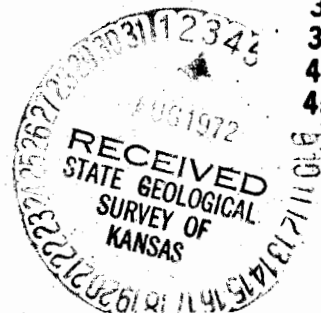

LOG TOPS

SC	1678
HEEB	3891
LANS	3941
BKC	4317
MARM	4370
PAWN	4423
FT SC	4472
CHER	4496
MISS LM	4587
MISS DOL	4593
TD	4610