


Section 25 Township 21 Range 12 W

Well No. #1 Salem

Company Hexagon Oil & Derby Oil

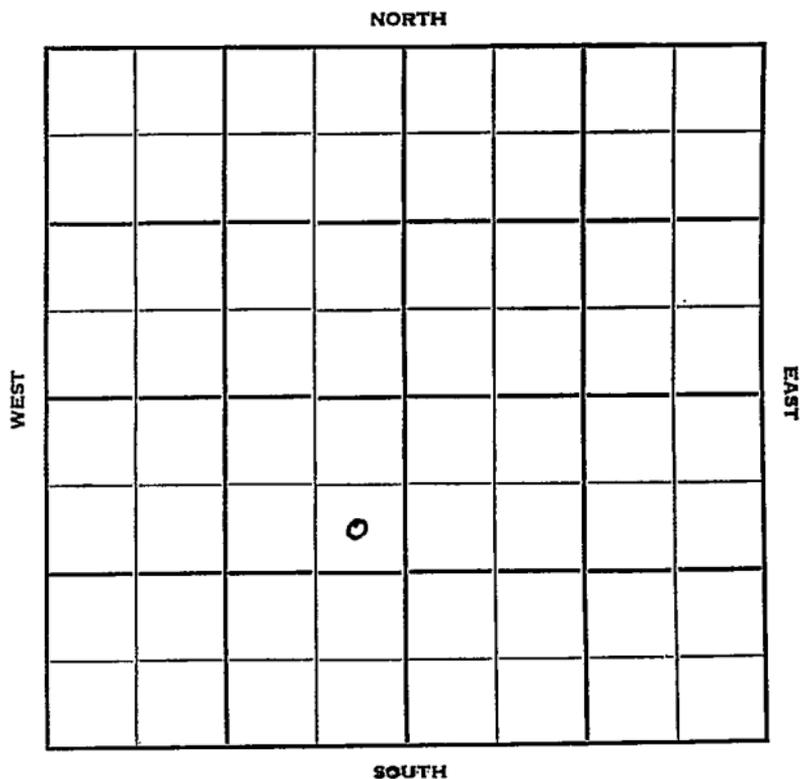

Stafford **KANSAS**
21 12W ✓

Sec. 25 Twp. _____ R. _____

Well No. #1 Salem Farm _____

Hexagon Oil & Derby Oil Company _____

Semi-Wildcat Contractor _____


990' Ft. from N. Line

_____ Ft. from S. Line

330' Ft. from E. Line

_____ Ft. from W. Line

SE NE SW

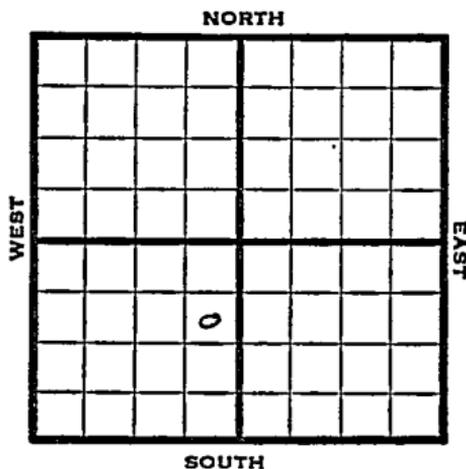

1951 Elev. 1805' REPORT

1/17 Spud 1-11-51
8" @ 251

Drlg. 2950'

2/7 Spud 1-11-51
D&A TD 3590

8" @ 251' Heeb. 3070

Br Lime 3202' Lans. 3219'

Sh. Cong. 3502 Cong. 3538'

DST 3488-2544 opn 15 min Rec. 10' mud

DST 3490-3590 opn 45 min Rec. 80' mud

5" @ 3563 TD 3590' B/l gwph 58 qt.

3567-90 CO to 3585 FU 60' wtr

SSO SP 3570 70 qt/3540-70

CO to 3555 D&A

ABANDONED

