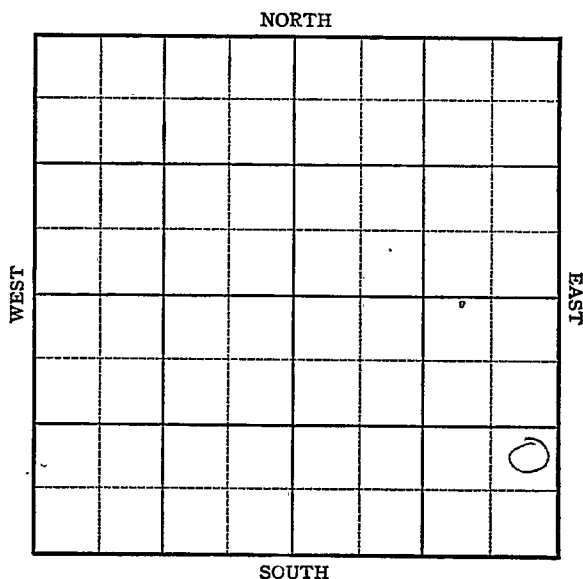
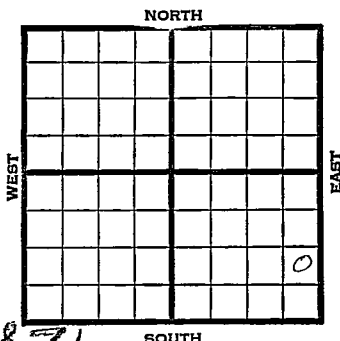


Section 25 Township 21 Range 13WWell No. #1 H. & B. FischerCompany Virginia Drlg.

KANSAS

Stafford County

Sec. 25 Twp. 21 R. 13WWell No. #1 H. & B. Fischer FarmVirginia Drlg. Company
Wildcat Ft. from N. Line990 Ft. from S. Line330 Ft. from E. Line Ft. from W. LineNE SE SE Elev. 1871

SOUTH

1945

REPORT

3/28 SH
 4/5. 8" @ 285
 Drlg; 1850
 4/12 Drlg. 3293
 4-18 Lens 3315'
 BKC 3536'
 Viola 3594'
 Simp 3643'
 Arb. 3702'
 Total Depth 3737'

ABANDONED

Pool Name WildcatMap No. 82 Sec. 25 Twp. 21 R. 13WWell No. 1 H. & B. FischerVirginia Drlg.


Company

IRST REPORT

Contractor

NE SE SE

SECTION PLAT

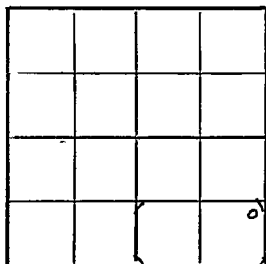 Ft. from N. Line990 Ft. from S. Line330 Ft. from E. Line Ft. from W. LineStaffordLocation Rig up

Drilling and Remarks:

SH

RECORD

Cased in., ft.Sand Gas Oil Total Depth

PRODUCTION

1st 24 hrs. Nat. 1st 24 hrs. after shot Gas Cu. Ft.Dry Hole Abandoned

Date

MAR 28 194519S. J. LEWISScout

Kansas Pool Name WildcatMap No. 82 Sec. 25 Twp. 21 R. 13WWell No. I H & B FischerVirginia Drlg.

Company

ABANDONED

Contractor

NE SE SE

No E1.

SECTION PLAT

			o

Ft. from N. Line

990 Ft. from S. Line330 Ft. from E. Line

Ft. from W. Line

Stafford County

Location

Rig up

Drilling and Remarks:

Kans 3315
BKC 3536
Viola 3594
Emp 3643
Ch 3702

RECORD

Cased _____ in., _____ ft.

Sand _____

Gas _____

Oil _____

Total Depth 3222

PRODUCTION

1st 24 hrs. Nat. _____

1st 24 hrs. after shot _____

Gas _____ Cu. Ft.

Dry Hole _____

Abandoned _____

Date

APR 18 1945 19

S. J. LEWIS Scout