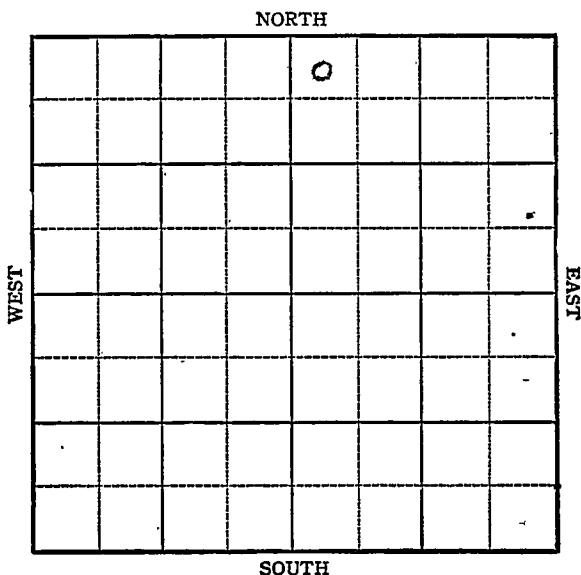


KANSAS

FORM 51 5M BR1X

Stafford

Section 25 Township 21 Range 13WWell No. #1 AlpersCompany Amerada

KANSAS

Sec. 25 Twp. 21 R. 13W

Well No. #1, Alpers

Farm

Amerada

Company

Wildcat


330 Ft. from N. Line

 Ft. from S. Line

 Ft. from E. Line

330 Ft. from W. Line

Elev. 1868

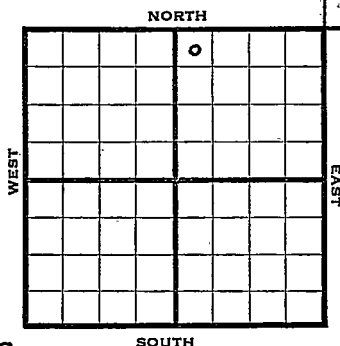

1944

REPORT

6/14 Location

6/21 Cellar

6/28 Derrick

7-12 Lans 3301'

Cong 3546'

Viola 3553'

Drilling 3638'

7-19 Simp 3636'

Arb. 3658'

TD 3702'

5" at 3702'

RUST SO

7-26 "

8-2 Perf. 40 shots 3670-80'

500 acid

8-9 32 shots 3674-80

Acidized with 3000 gallons.

8-16 42 shots at 3660-70'

1000 acid

- 8-23 Swb 6 fluid in 24 hrs. 25% water

8-30 " " " " "

9/6 Arb. 3659

5" @ 3702

TD 3702

3658
1868
-1790

ABANDONED

Pool Name Wildcat**KANSAS**Map No. 8 Sec. 25 Twp. 21 R. 13WWell No. 1 AlpersAmerada


Company

FIRST REPORT

Contractor

NW NE

SECTION PLAT

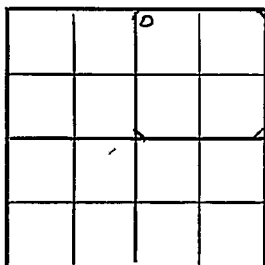330 Ft. from N. Line Ft. from S. Line Ft. from E. Line330 Ft. from W. LineStafford CountyLocation XRig up

Drilling and Remarks:

RECORD

Cased in., ft.Sand Gas Oil Total Depth

PRODUCTION

1st 24 hrs. Nat. 1st 24 hrs. after shot Gas Cu. Ft.Dry Hole Abandoned

Date

JUN 14 1944

19

S. J. LEWIS

Scout

KANSAS

Pool Name WildcatMap No. 82 Sec. 25 Twp. 21 R. 13WWell No. 1 AlpersAmerada

Company

ABANDONED

Contractor

NW NE

SECTION PLAT

		o	

330 Ft. from N. Line Ft. from S. Line Ft. from E. Line330 Ft. from W. LineStafford CountyLocation Rig up

Drilling and Remarks:

See 836595' @ 3702

RECORD

Cased in., ft.Sand Gas Oil Total Depth 3702

PRODUCTION

1st 24 hrs. Nat. 1st 24 hrs. after shot Gas Cu. Ft.Dry Hole Abandoned

Date

SEP 6 1944 19

S. J. LEWIS Scout