

KANSAS Stafford County

FORM 51 5M 11-44 PETROL

Section 25 Township 21 Range 13W

Well No. #1 Fanskier

Company W. P. Faulkner

NORTH

WEST	C							
SOUTH								

KANSAS Stafford County

Sec. 25 Twp. 21 R. 13W

Well No. #1 Fanskier Farm

W. P. Faulkner Company

Wildcat


330 Ft. from N. Line

Ft. from S. Line

Ft. from E. Line

330 Ft. from W. Line

NW/c Edw. 1867

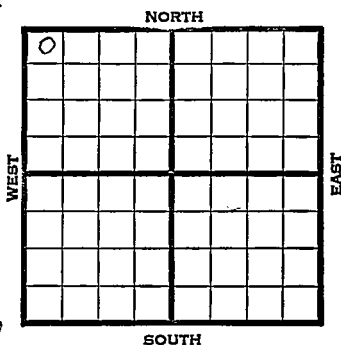

1945

REPORT

3/28	Location
4/5	"
4/12	"
4/20	"
4/27	8" @ 232 Drlg. 535
5/3	Drlg. 2820
5/16	Arb 3696 TD 3742

ABANDONED

Pool Name WildcatMap No. 82 Sec. 25 Twp. 21 R. 13WWell No. 1 Fan skierW. P. Faulkner

Company

FIRST REPORT

Contractor

NW/c

SECTION PLAT

330 Ft. from N. Line Ft. from S. Line Ft. from E. Line330 Ft. from W. Line

0			

StaffordLocation Rig up

Drilling and Remarks:

RECORD

Cased in., ft.Sand Gas Oil Total Depth

PRODUCTION

1st 24 hrs. Nat. 1st 24 hrs. after shot Gas Cu. Ft.Dry Hole Abandoned

Date

MAR 28 1945 19S. J. LEWIS Scout

ans 22 Pool Name Wildcat

Map No. 82 Sec. 25 Twp. 21 R. 13 W.

Well No. 1 Fanskier

W. P. Faulkner Company

ABANDONED Contractor

NW/c

E 1/867
SECTION PLAT

330 Ft. from N. Line

 Ft. from S. Line

 Ft. from E. Line

330 Ft. from W. Line

0			

Stafford County

Location

Rig up

Drilling and Remarks:

Cr & 3696

RECORD

Cased in., ft.

Sand

Gas

Oil

Total Depth 3742

PRODUCTION

1st 24 hrs. Nat.

1st 24 hrs. after shot

Gas Cu. Ft.

Dry Hole

Abandoned

Date

MAY 16 1945

19

S. J. LEWIS Scout