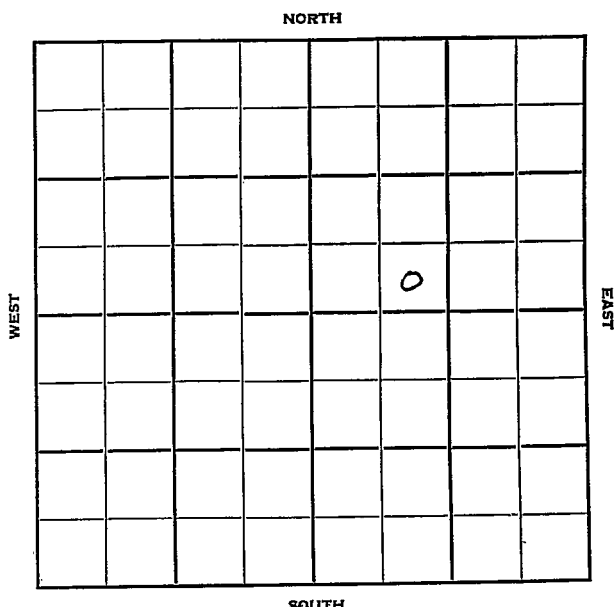


Section 25 Township 21 Range 13WWell No. #2 AlpersCompany Nadel & Gussman

Stafford

KANSAS

Sec. 25 Twp. 21 R. 13 W

Well No. # 2 Alpers Farm

Nadel & Gussman Company

Reserve Contractor
Fischer


 Ft. from N. Line

330 Ft. from S. Line

 Ft. from E. Line

990 Ft. from W. Line

SE SW NE

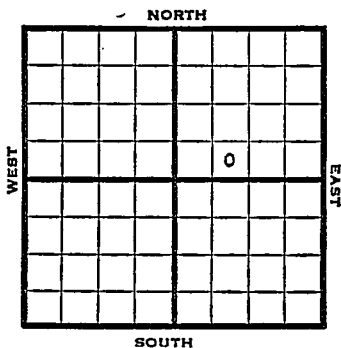

1951

Elev. 1872' REPORT

11/7

Drlg. 1500'

1952

1/23

Spud 11-1-51

Oil Well TD 3707

8" @ 295

Lans. 3318 Viola 3577

Simp. 3653 Arb. 3657


TD 3707

5" @ 3706 35/3657-65 500 A

S/5½ boph Comp. 34 bopd

COMPLETED

County Stafford State Kansas
 Sec. 25 (Blk. 21) (Sur. 13W) Map No. 13W
 Operator Nadel & Gussman
 Well No. 2 Farm Alpers
 Elev. Location SE SW NE

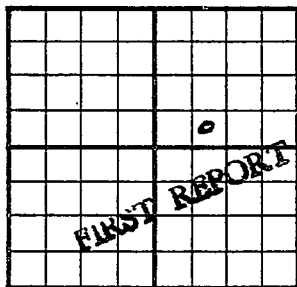

330 Ft. From S Line NE
990 Ft. From N Line Quarter

Ist. Report NOV 7 1951

Completion

Remarks

Reserve - Contr.

Spudding Date

Drlg. Data Fischer

Drlg. 1500

J. E. TYRA

County Stafford State Kansas
 Sec. 25 (Blk. 21) (Sur. 13W) Map No.
 Operator Nadel & Gussman
 Well No. 2 Farm Alpers
 Elev. 1872 Location SE SW NE

330 Ft. From S Line NE

990 Ft. From W Line Quarter

1st. Report

Completion JAN 23 1952Remarks Fischer PoolReserve Drlg. - Contr.Spudding Date 11-1-51Drlg. Data Oil well TD 37078" @ 295 Lans. 3318 Viola 3577Simp. 3653 Arb. 3657 TD 37075" @ 3706 '35/ 3657-65 500 AS/ 5½ boph 'Comp. 34 bopd

J. G. McGEHEE