

Section 25 Township 21 Range 13WWell No. #2 Pischer (E)Company Nadel & Gussman

NORTH

WEST

EAST

|   |  |  |  |  |  |  |  |
|---|--|--|--|--|--|--|--|
|   |  |  |  |  |  |  |  |
|   |  |  |  |  |  |  |  |
| 0 |  |  |  |  |  |  |  |
|   |  |  |  |  |  |  |  |

SOUTH

Stafford

KANSAS  
13 W

Sec. 25 Twp. 21 R. 13 W

Well No. # 2 Fischer (E) Farm

Nadel & Gussman Company

Reserve Contractor

Fischer


         Ft. from N. Line

990 Ft. from S. Line

         Ft. from E. Line

330 Ft. from W. Line

NW SW SW

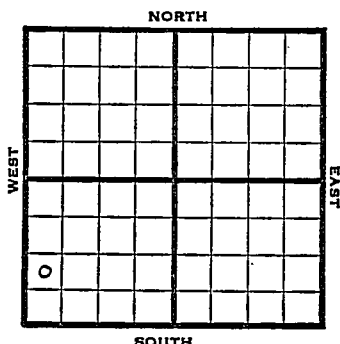

1951

Elev. 1874' REPORT

10/17

Location

12/5

Spud 10-17-51

Oil well TD 3643' 8" @ 284'

Anhy 708' Heeb 3158' Br. lime 3286'

Lans. 3303'

DST 3329-47 open 20 min. rec 240'

O & GCM.

Viola 3535' Simp. 3589' Sand 3619'

Arb. 3635' TD 3637' 5" @ 3637'

DD 3643' 1000 A S/46 BOPH

Comp. Echo pot. 1397 BOPD

COMPLETED

J. E. TYRA

County Stafford State Kansas

Sec. 25 (Blk. Twp.) 21 (Sur. Rge.) 13W Map No.

Operator      Nadel & Gussman

Well No. 2 Farm Fischer "E"

Elev. 1874      Location NW SW SW

990 Ft. From S Line SW

330 Ft. From W Line Quarter

1st. Report

Completion DEC 5 1951

Remarks Fischer Pool

Reserve Drlg. - Contr.

Spudding Date **10-17-51**

Drig. Data      Oil well      TD 3643

8" @ 284 Anhy 708 Heeb. 3158

Br. lime 3286    Lans. 3303    DST 3329-47

open 20 min. Rec. 240' o & gcm

Viola 3535      Simp. 3589      Sarda 3619

Arb. 3635    TD 3637    5" @ 3637    DD 3643

1000 A S/ 46 boph

Comp. Echo pot. 1397 bopd

J. E. TYRA