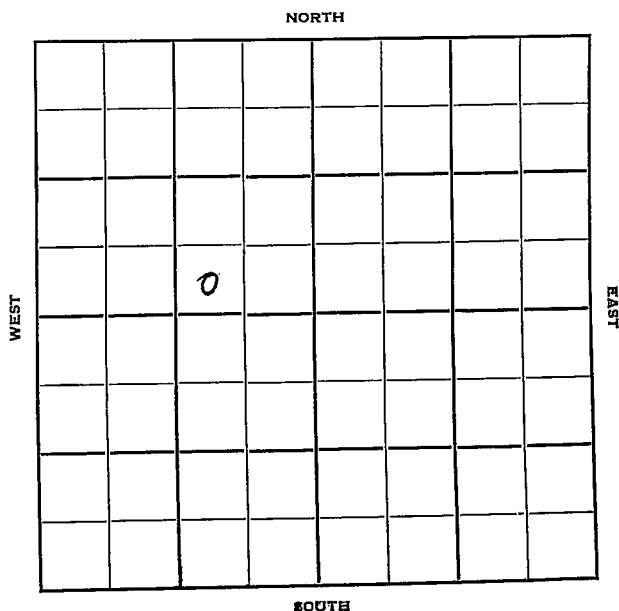


Section 25 Township 21 Range 13WWell No. #4 FanshierCompany Nadel & Gussman

Stafford

KANSAS
13 W

Sec. 25 Twp. 21 R. 13

Well No. # 4 Fanshier Farm

Nadel & Gussman Company

Reserve Drlg. Contractor
Fischer Pool


 Ft. from N. Line

330 Ft. from S. Line

990 Ft. from E. Line

 Ft. from W. Line

SW SE NW

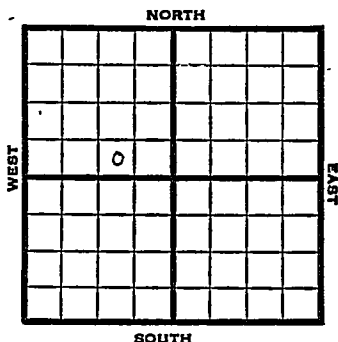

1951 Elev. 1876' REPORT

10/3 RUBR

11/14


Spud 10-3-51
Oil Well TD 3625
8" @ 300
Anhy 705 Lans. 3308
DST 3447-60 open 20 min.
Rec. 240' oil
DST 3463-80 open 1 hr.
Rec. 2050' gas 95' HOCM 85' oil
Viola 3537 Simp. 3573
Arb. 3624
5" @ 3625 TD
Perf/ 3488-94 2 GOPH SP 3480
39/ 3456-65 2000 A F/ 50 BOPH
Comp. 3000 BOPD

COMPLETED



J. E. TYRA

County Stafford State Kansas
 Sec. 25 (Blk. 21 (Sur. 13W Map No.
 Operator Nadel & Gussman
 Well No. 4 Farm Fanshier
 Elev. 1876 Location SW SE NW

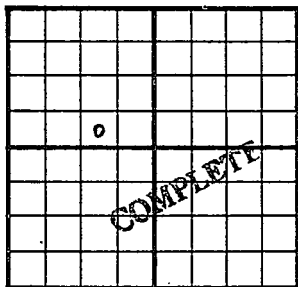

330 Ft. From S Line NW
 990 Ft. From E Line Quarter

1st. Report

Completion NOV 14 1951

Remarks Fischer Pool
Reserve Drlg. - Contr.

Spudding Date 10-3-51

Drlg. Data Oil well TD 3625

8" @ 300 Anhy 705 Lans. 3308

DST 3447-60 open 20 min. Rec. 240' oil

DST 3463-80 open 1 hr. Rec. 2050' gas

95' hocrn 85' oil Viola 3537

Simp. 3573 Arb. 3624 5" @ 3625 TD

Perf/ 3488-94 2 goph SP 3480

39/ 3456-65 2000 A F/ 50 bopd

Comp. 3000 bopd