

FORM 51 25M 3-49 PETROL Stafford

Section 25 Township 21 Range 13W

Well No. #10 Fischer "B"

Company Nadel & Gussman

NORTH

WEST

EAST

SOUTH

0

Stafford

KANSAS ✓

Sec. 25 Twp. 21 R. 13 W

Well No. # 10 Fischer "B" Farm

Nadel & Gussman Company

Reserve Drlg. Contractor


Ft. from N. Line

330 Ft. from S. Line

Ft. from E. Line

990 Ft. from W. Line

SE SW SE

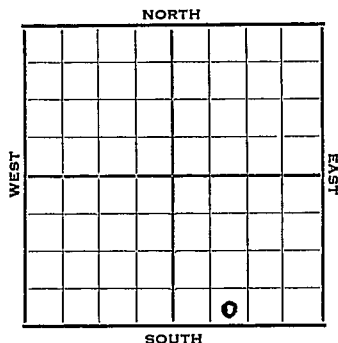

1952

Elev. 1875' REPORT

10/29 RUR

11/5 10" @ 300
Anhy 695'
Drlg. 2980'

11/12 Br li 3288' Lans. 3304'

11/20 Cong. 3572'
TD 3675' in Cong 5" @ 3500

11/27 NR

12/4 "

12/11 48/3434-42 wtr / SSO 24/3382-86
500A F 40 BO 12 Hrs. POP

12/18 NR

12/25 NR

1/1 NR

1/8 NR

1/23 Spud 10-27-52 Oil well TD 3675'
10" @ 300 Anhy 695' Br. line 3288'
Lans. 3304' Cong. 3572' TD 3675'
5" @ 3500 48/3434-42 wtr & SSO
24/3382-86 500 A F/40 BO 12 hr.
Comp. 227 BOPD

COMPLETED

J. G. McGEHEE