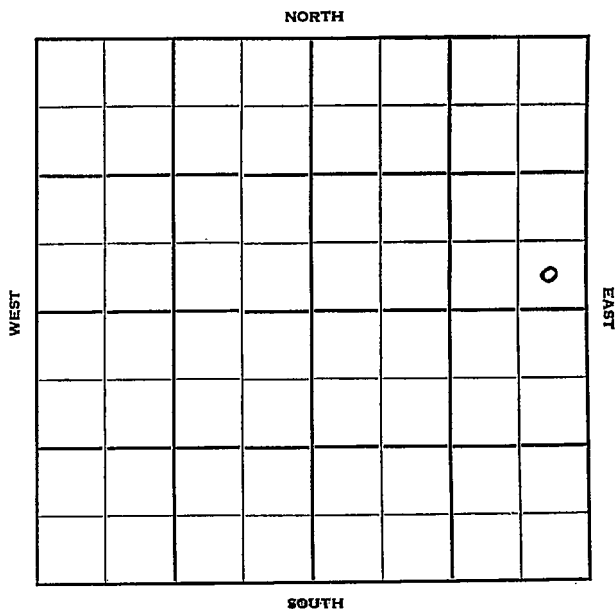


Section 25 Township 21 Range 14 WWell No. #2 BaierCompany G-M-R Oil

Stafford **KANSAS**

Sec. 25 Twp. 21 R. 14W ✓

Well No. #2 Baier Farm

G-M-R Oil Company

SW Pundsack Pool Contractor


 Ft. from N. Line

330' Ft. from S. Line

330' Ft. from E. Line

 Ft. from W. Line

SE SE NE

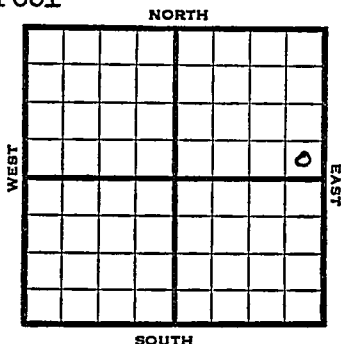

1951

REPORT

1/24

Spud 1-20-51
8" @ 194'
Anhy 815'
Drilg. 1830'

2/21

Spud 1-20-51
Oil Well TD 3745
8" @ 194' Anhy 815'
Br Lime 3380' Lans. 3391'
DST 3567-84 opn 45 min
Rec. 15' mud Cong. 3641' Viola 3656'
Simp. 3694' Arb. 3741
DST 3741-45 opn ½ hr
Rec. 30' mud & SSO 5" @ 3743
TD 3745 500 A S/6 boph
Comp. 160 bopd

COMPLETED

County Stafford State Kansas
 Sec. 25 (Blk. Twp.) 21 (Sur. Rge.) 14W Map No. _____
 Operator G-M-R Oil
 Well No. 2 Farm Baier
 Elev. _____ Location SE SE NE

FIRST REPORT

330 Ft. From S Line NE
330 Ft. From E Line Quarter

Ist. Report JAN 24 1951

Completion _____

Remarks _____

Spudding Date 1-20-51

Drlg. Data

SW Fundsack Pool

8" @ 194 Anhy 815 drlg. 1830


J. E. TYRA

County Stafford State Kansas
 Sec. 25 (Blk.
Twp.) 21 (Sur.
Rge.) 14W Map No.

Operator G-M-R Oil

Well No. 2 Farm Baier

Elev. 1920 Location SE SE NE

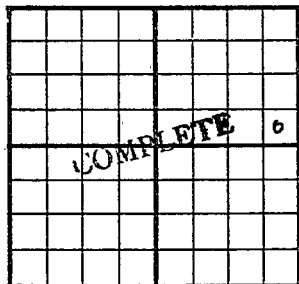

330 Ft. From S Line NE

330 Ft. From E Line Quarter

1st. Report

Completion FEB 21 1951

Remarks SW Pundsack Pool

Spudding Date 1-20-51

Drig. Data Oil well TD 3745

8 $\frac{1}{2}$ " @ 194 Anhy 815 Br. lime 3380

Lans. 3391 DST 3567-84 open 45 min.

Rec. 15' mud Cong. 3641 Viola 3656

Simp. 3694 Arb. 3741 DST 3741-45

open $\frac{1}{2}$ hr. Rec. 30' mud & SSO 5" @ 3743

TD 3745 500 A S/ 6 boph

Comp. 160 bopd

J. E. TYRA