


Section 25 Township 21 Range 14 WWell No. # 2 Baier (A)Company G. M. R. Oil Co.

NORTH

WEST

EAST

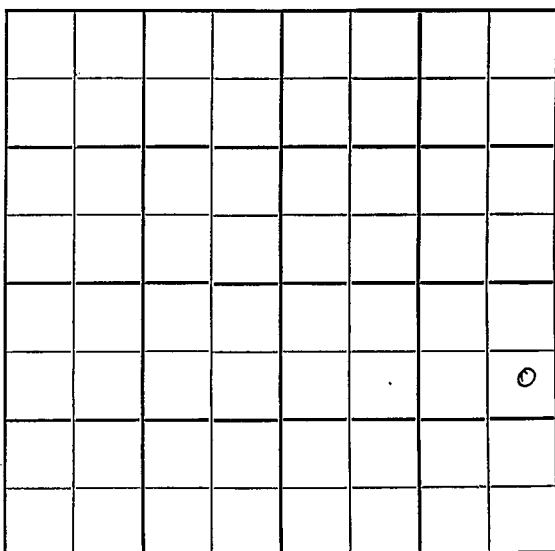

SOUTH

Stafford

KANSAS

Sec. 25 Twp. 21 R. 14 W ✓

Well No. # 2 Baier (A) Farm

G.M.R. Oil Company Company

Contractor


990 Ft. from N. Line

Ft. from S. Line

330 Ft. from E. Line

Ft. from W. Line

SE NE SE

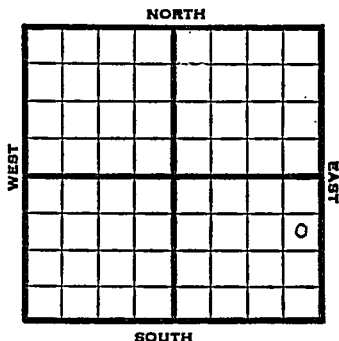

1951

Elev. 1922'

REPORT

7/3

Location

8/22

Spud 8-5-51

D&A TD 3795

8" @ 253

Br Lime 3395

Lans. 3405

Cong. 3659

Viola 3680

Simp 3727


Arb. 3778

TD 3795

D&A

ABANDONED

J. E. TYRA

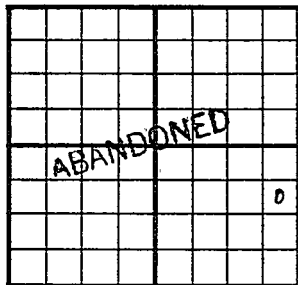County Stafford State KansasSec. 25 (Blk.
Twp.) 21 (Sur.
Rge.) 14W Map No.Operator G-M-R OilWell No. 2 Farm Baier "A"Elev. 1922 Location SE NE SE990 Ft. From N Line SE330 Ft. From E Line Quarter

1st. Report

Completion AUG 22 1951

Remarks

Spudding Date 8-5-51Drilg. Data D & A TD 37958" @ 253 Br. lime 3395 Lans. 3405Cong. 3659 Viola 3680 Simp. 3727Arb. 3778 TD 3795D & A

J. E. TYRA