


Stafford

KANSAS

SECTION 25 TOWNSHIP 21 RANGE 14W

WELL NO. #1 Parker "A"

COMPANY B.E. Ash

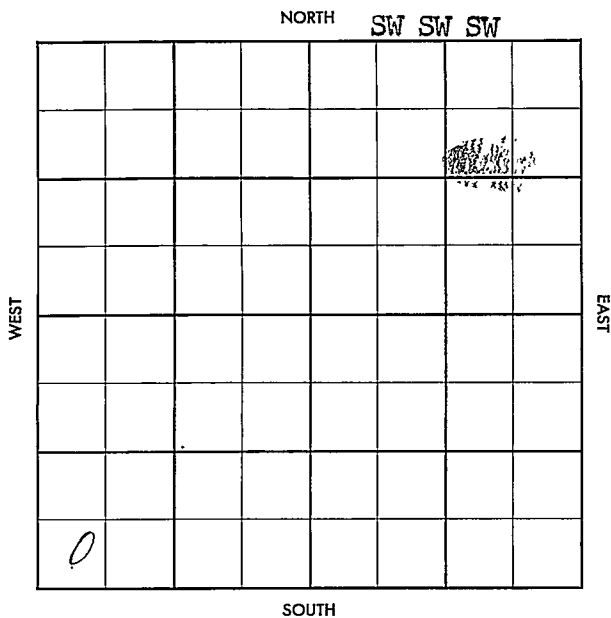

WILDCAT

County Stafford

Elev. _____

Sec. 25Twp. 21Rgs. 14WCompany B. E. AshFarmName Parker "A"No. 1

TOPS

DEPTH

LOG

DATUM

Loc. in Sec. _____

Anh. _____

Tp. _____

H. _____

Tr. _____

Dg. _____

Bl. _____

L. _____

K.C. _____

B.K.C. _____

Ce. _____

C. _____

M. _____

M. _____

K. _____

Mz. _____

Mq. _____

V. _____

S. _____

S. _____

A. _____

R. _____

PE. _____

G. _____

T.D. _____

SW SW SW

Geol. _____

Contr. _____

Bea Drlg. Tl. _____

Pool _____

Wildcat

FEB 13 '57

FIRST REPORT

0

Date Comm. _____

R U R

13

County StaffordElev. 1936Sec. 25Twp. 21Rgs. 14WCompany B. E. AshFarmName Parker "A"No. 1

TOPS	DEPTH	LOG	DATUM	Loc. in Sec.
Anh.				SW SW SW
Ip.				
H.	3297			
Tr.	3320			
Dg.	3336			
Bl.	3419			
L.	3429			
K.C.				Geol.
B.K.C.				Contr.
Ce.				Bea Drlg. Tls.
C.				Pool
M.				Wildcat
M.				
K.				
Mz.				
Mo.				
V.	3698			
S.	3740			
S.				
A.	3788			
R.				
Pe.				
G.				
TD.	3830			

Date Comm.

R U R FEB 20 '57

2-12-57 8578

347/250 17 2885 FEB 21 '57

D E Q.