

KANSAS Pawnee

Section 25 Township 21 Range 15WWell No. 1 WarnerCompany Continental

Wildcat

NORTH

			0				

WEST

EAST

SOUTH

HOT FILE KANSAS

Pawnee ✓


Sec. 25 Twp. 21 R. 15WWell No. 1 Warner FarmContinental CompanyWildcat330 Ft. from N. Line

Ft. from S. Line

330 Ft. from E. Line

Ft. from W. Line

NE NW

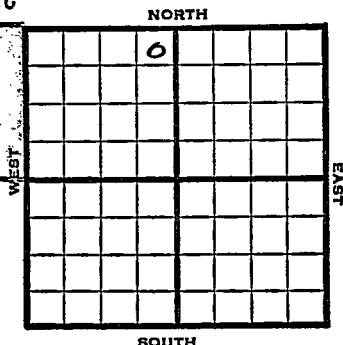

1948

Elev 1965'

REPORT

11/17 Location

11/23 "

11/30 "

12/6 "

12/14 "

12/22 13" @ 240'

12/29 9" @ 914'

Drlg. 2875'

1949

1/12 TD 3886'

Lansing 3465'

BKC 3679'

Cong 3731'

Viola 3757'

Simpson 3804'

Arb 3851'

Aband.

ABANDONED

Map No. _____ Sec. 25 Twp. 21 R. 15W.

Well No. 1 Warner

Continental

Company

FIRST REPORT

Contractor

NE NW

SECTION PLAT

330 Ft. from N. Line

 Ft. from S. Line

330 Ft. from E. Line

 Ft. from W. Line

Pawnee County

Location X

Rig up _____

Drilling and Remarks:

RECORD

Cased _____ in., _____ ft.

Sand _____

Gas _____

Oil _____

Total Depth _____

PRODUCTION

1st 24 hrs. Nat. _____

1st 24 hrs. after shot _____

Gas _____ Cu. Ft.

Dry Hole _____

Abandoned _____

Date

NOV 17 1948

19

S. J. LEWIS Scout

Kansas

Map No. 82 Sec. 25 Twp. 21 R. 15WWell No. 1 WarnerContinental

Company

ABANDONED

Contractor

NE NW

E 1/8 65
SECTION PLAT330 Ft. from N. Line Ft. from S. Line330 Ft. from E. Line Ft. from W. Line

Pawnee County

		0	

Location Rig up

Drilling and Remarks:

Lease 3465
B/C 3679
Comp 3731
Vista 3757
Sing 3804
Art 3831

RECORDCased in., ft.Sand Gas Oil Total Depth 3976**PRODUCTION**1st 24 hrs. Nat. 1st 24 hrs. after shot Gas Cu. Ft.Dry Hole Abandoned

Date

JAN 12 1949 19S. J. LEWIS

Scout