

KANSAS


Stafford

Section 25 Township 21 21 Range 11-W

Well No. #1 Estey

Company Virginia Drilling

Wildcat

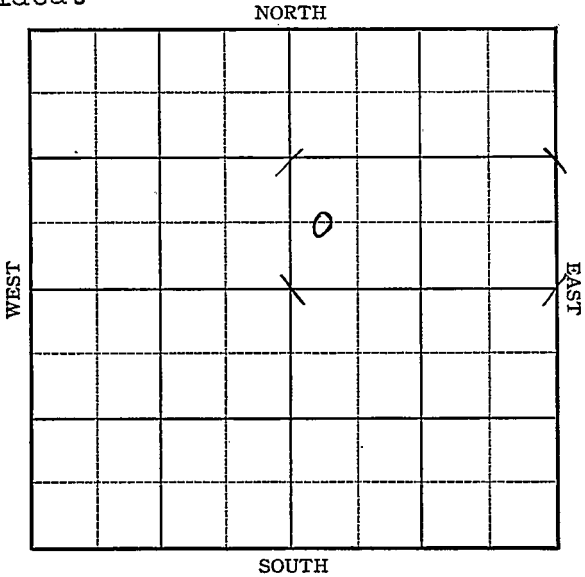

KANSAS

Stafford

Sec. 25 Twp. 21 R. 11th

Well No. #1 Estey Farm

Virginia Drilling Company


Wildcat

 Ft. from N. Line

660 Ft. from S. Line

 Ft. from E. Line

330 Ft. from W. Line

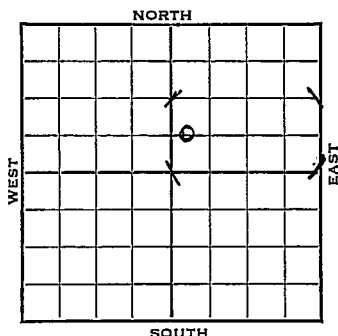

C WL SW NE

1942	REPORT
11/10	8" - 210' Waiting on cement
11/18	Drlg 1955
11/24	Lans. 3073 Drlg. 3215
12/2	Congl. 3374 Simp. sd. 3408 Arb. 3467 T.D. 3500' No shows.
	ABANDONED

Map No. 46 Sec. 25 Twp. 21 R. 11W

Well No. 1 Estey

Virginia Drilling Company

FIRST REPORT Contractor

C WL SW NE


SECTION PLAT

 Ft. from N. Line

660 Ft. from S. Line

 Ft. from E. Line

330 Ft. from W. Line

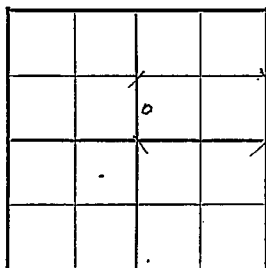

WILDCAT

Location

Rig up

Drilling and Remarks:

8"-210'

Waiting on
cement

RECORD

Cased in., ft.

Sand

Gas

Oil

Total Depth

PRODUCTION

1st 24 hrs. Nat.

1st 24 hrs. after shot

Gas Cu. Ft.

Dry Hole

Abandoned

Date

NOV 11 1942

19

S. J. LEWIS

Scout

KANSASMap No. 16 Sec. 25 Twp. 21 R. 11WWell No. 1 EsteyVirginia Drilling CompanyABANDONED Contractor

C WL SW NE

 Ft. from N. Line660 Ft. from S. Line Ft. from E. Line330 Ft. from W. Line

SECTION PLAT

		o	

WILDCATLocation Rig up

Drilling and Remarks:

*Coop 13374**Emp. Sol 13408**Cr 13467**No shows*

RECORD

Cased in., ft.Sand Gas Oil Total Depth 2510

PRODUCTION

1st 24 hrs. Nat. 1st 24 hrs. after shot Gas Cu. Ft.Dry Hole Abandoned

Date

DEC 2 194219S. J. LEWIS Scout