


Section 25 Township 21 Range 16 WWell No. #1 Wilson "B"Company Colorado O&G

NORTH

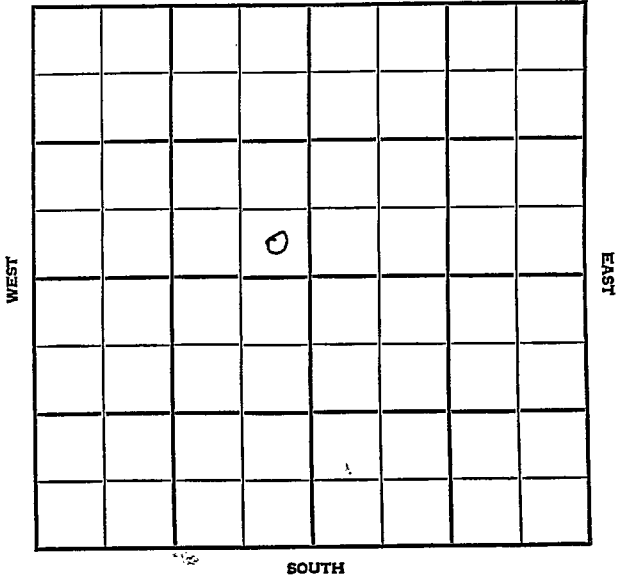

Pawnee

KANSAS

|      |      |     |
|------|------|-----|
| SEC. | TWP. | R.  |
| 25   | 21   | 16W |

WELL NO.

#1 Wilson "B"

FARM

COMPANY

Colorado O & G

CONTRACTOR

Harms & Burt


SW Sweeney

\_\_\_\_\_ Ft. from N. Line

\_\_\_\_\_ Ft. from S. Line

\_\_\_\_\_ Ft. from E. Line

\_\_\_\_\_ Ft. from W. Line

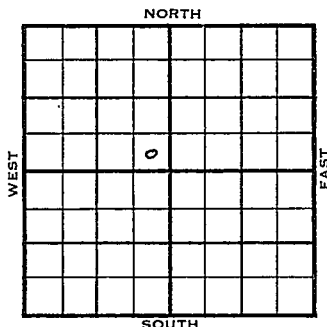

SE SE NW

| 1955 | ELEVATION | REPORT |
|------|-----------|--------|
|      | 1973'     |        |

8/17 Location

9-7

Comm 118-23-55

8 5/8" @ 955/450

DST 3471-3522, open 1 hr., rec. 20' mud 180/20"

DST 3867-85, open 45 min., rec. 360' mud

DST 3875-95, open 75 min., rec. 105' mw 1140/30"

DST 3868-3905, failed

DST 3880-3905, open 1 hr., rec 630' msw D & A

TOPS

DEPTH

H. 3362

B.L. 3463

L. 3470

B.K.C. 3705

sh 3740

Cong Ch 3756

V. 3770

S. 3843

A 3868

T.D. 3905'

**ABANDONED**

County Paymee Elev. \_\_\_\_\_  
 Sec. 25 Twp. 27 Rge. 16W  
 Company Colorado O & G  
 Farm Name Wilson "B" No. 7

| TOPS   | DEPTH | LOG | DATUM | Loc. in Sec.   |
|--------|-------|-----|-------|---|
| Anh.   |       |     |       | SE SE NW   |
| TP.    |       |     |       |   |
| H.     |       |     |       |   |
| Tr.    |       |     |       |   |
| Dg.    |       |     |       |   |
| BL.    |       |     |       |   |
| L.     |       |     |       | Geol.   |
| K.C.   |       |     |       | Contr.   |
| B.K.C. |       |     |       | Harms & Burr   |
| Ce.    |       |     |       |   |
| C.     |       |     |       | Pool   |
| M.     |       |     |       | SW Sweeney   |
| M.     |       |     |       | <div style="border: 1px solid black; padding: 5px; text-align: center;">             AUG 17 '55<br/>             0<br/>             FIRST REPORT           </div> |
| K.     |       |     |       |   |
| Mz.    |       |     |       |   |
| Mo.    |       |     |       |   |
| V.     |       |     |       |   |
| S.     |       |     |       |   |
| S.     |       |     |       |   |
| A.     |       |     |       |   |
| R.     |       |     |       |   |
| PE.    |       |     |       |   |
| G.     |       |     |       |   |
| TD.    |       |     |       |   |

Date Comm.

Location

County Pawnee Elev. 1973  
 Sec. 25 Twp. 21 Rge. 16W  
 Company Colorado O & G  
 Farm Name Wilson "B" No. 1

| TOPS              | DEPTH | LOG | DATUM | Loc. in Sec. |
|-------------------|-------|-----|-------|--------------|
| Anh.              |       |     |       | SE SE NW     |
| Tp.               |       |     |       |              |
| H.                | 3362  |     | 1389  |              |
| Tr.               |       |     |       |              |
| Dg.               |       |     |       |              |
| Bl.               | 3413  |     | 1490  |              |
| L.                | 3470  |     | 1497  | Geol.        |
| K.C.              |       |     |       | Contr.       |
| B.K.C.            | 3705  |     | 1732  |              |
| Ce.               |       |     |       |              |
| C. <u>sh</u>      | 3740  |     | 1767  | Harms & Burt |
| M. <u>Can. ch</u> | 3756  |     | 1783  | Pool         |
| M.                |       |     |       | SW Sweeney   |
| K.                |       |     |       |              |
| Mz.               |       |     |       |              |
| Mo.               |       |     |       |              |
| V.                | 3770  |     | 1797  |              |
| S.                | 3843  |     | 1870  |              |
| S.                |       |     |       |              |
| A.                | 3868  |     | 1895  |              |
| R.                |       |     |       |              |
| Pe.               |       |     |       |              |
| G.                |       |     |       |              |
| T.D.              | 3915  |     |       |              |

Date Comm. 8-23-55 SEP 7 1955

8 5/8" @ 955/150 DST 3471-3522

open 1 hr. Rec. 20' mud 180/20"

DST 3867-85 open 45 min. Rec. 30'

mud DST 3875-95 open 75 min.

Rec. 105' mw 1110/30" DST 3868-3905

failed DST 3880-3905 open 1 hr.

Rec. 630' msu

D & A

ABANDONED