

Pawnee


KANSAS

SECTION 25 TOWNSHIP 21 RANGE 19 W

WELL NO. #1 Proffitt

COMPANY Welch & Olsson

NORTH

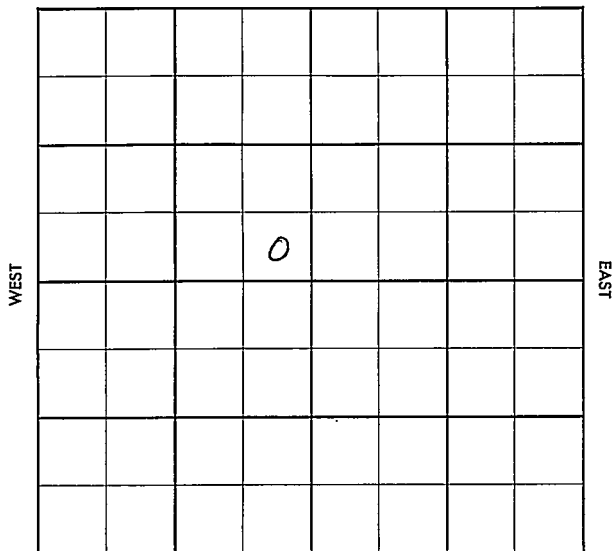

SOUTH

Pawnee

KANSAS

SEC.	TWP.	R.
25	21	19W

WELL NO.

#1 Proffitt

FARM

COMPANY

Welch & Olsson

CONTRACTOR

Co. Tools

~~###~~ Wildcat


Ft. from N. Line

Ft. from S. Line

Ft. from E. Line

Ft. from W. Line

SE SE NW

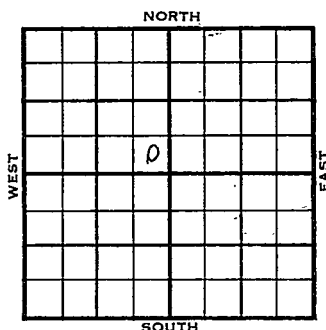

Lion - DHM & BHM

	ELEVATION	REPORT
1955	2066	
12-14	Comm. 12-9-55 8" @ 190/175 Drlg. 2500 Anh 1168	
12-28	DST 4171-80 op 1 hr. rec. 120' wm, 1360/30" D & A H. 3602 L. 3677 Shly 4138 Cg. Chert 4170 Cherty 4263 Viola lm. 4333 TD 4355'	

ABANDONED

County Parise Elev. _____
 Sec. 25 Twp. 21 Rge. 19W
 Company Walch & Olsson
 Farm Name Proffitt No. 1

TOPS	DEPTH	LOG	DATUM	Loc. in Sec.
Anh.	<u>1168</u>			<u>SE SE NW</u>
Tr.				
H.				
Tr.				
Dg.				
BL.				
L.				Geol. _____
K.C.				Contr. _____
B.K.C.				<u>Co. tools</u>
Ce.				
C.				Pool _____
M.				<u>Wildcat</u>
M.				
K.				
Mz.				
Ma.				
V.				
S.				
S.				
A.				
R.				
Pe.				
G.				
T.D.				

FIRST REPORT

DEC 14 '55

Date Comm. 12-9-55 Lion - DHM & BHM
8" @ 190/175 drlg. 2500

County Pawnee Elev. 2066
 Sec. 25 Twp. 21 Rge. 19W
 Company Welch & Olsson
 Farm Name Proffitt No. 1

TOPS	DEPTH	LOG	DATUM	Loc. in Sec.
Anh.	1168			SE SE NW
TP.				
H.	3602		1536	
Tr.				
Dg.				
BL.				
L.	3677		1611	Geol.
K.C.				Contr.
B.K.C.				
Ce.				
C. <u>shly</u>	4138		2072	Co. tools
M. <u>Cg chert</u>	4176		2184	Pool
M.				Wildcat
K.				
Mz.				
Me.				
V. <u>cherty</u>	4263		2192	
S. <u>Viola</u>	4333		2267	
S.				
A.				
R.				
Pe.				
G.				
TD.	4355			

Date Comm. 12-9-55 DEC 2-8 1955

8" @ 190/175 DST 4171-80 open 1 hr.
 rec. 120' WM 1360/30"

D & A

ABANDONED