

SECTION 25 TOWNSHIP 21S RANGE 34W

WELL NO. #1-Jewell


COMPANY Nate Appleman

NE NE SW

NORTH

WEST

EAST

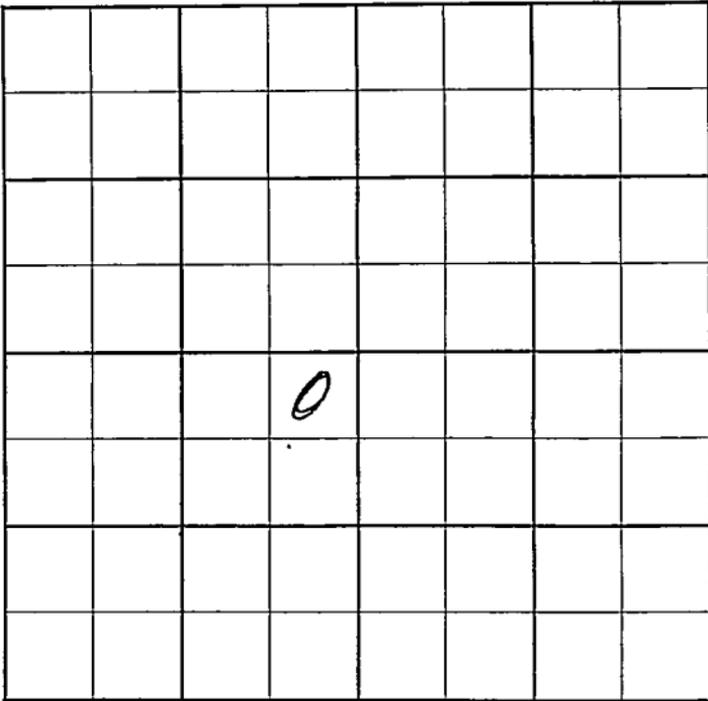

SOUTH

County Finney Elev. \_\_\_\_\_  
 Sec. 25 Twp. 21 Rge. 34W  
 Company Nate Appleman  
 Farm Name Jewell No. 1

TOPS	DEPTH	LOG	DATUM	Loc. in Sec.
Anh.				NE NE SW
Tr.				
H. <u>Herr.</u>	<u>2555</u>			
Dg.				
Bl.				
L.				Geol. _____
K.C.				Contr. _____
B.K.C.				
Ce.				<u>Garvey</u>
C.				Pool _____
M.				<u>Hugoton</u>
M.				
K.				
Mz.				
Me.				
V.				
S.				
S.				
A.				
R.				
Pe.				
G.				
T.D.	<u>2571</u>			

FIRST REPORT  
 0  
 JUL 17 '57

Date Comm. 7-10-57  
8" @ 289/200 5" @ 2559/150

~~35~~

Co.  
 Lse.  
 No.  
 Sec.  
 T.  
 R.

Co.  
Lse.  
No.  
Sec.  
T.  
R.

County Finney Elev. 2918  
 Sec. 25 Twp. 21 Rge. 34<sup>th</sup>  
 Company Noble App. Loman  
 Farm Name Jewell No. 1

TOPS	DEPTH	LOG	DATUM
Anh.			
TP.			
H. <u>Herr.</u>	<u>2555</u>		
Tr.			
Dg. <u>WFD</u>	<u>2610</u>		
Bl.			
L.			
K.C.			
B.K.C.			
Ce.			
C.			
M.			
M.			
K.			
Mz.			
Mo.			
V.			
S.			
S.			
A.			
R.			
PE.			
G.			
T.D.	<u>2571</u>		

Loc. in Sec. 34<sup>th</sup> N<sup>th</sup> SW  
 Geol. \_\_\_\_\_  
 Contr. \_\_\_\_\_  
Garvey  
 Pool \_\_\_\_\_  
Ingoton  

COMPLETE	

 JUL 31 '57

Date Comm. 7-10-57  
8" @ 289/200 5" @ 2559/150 JUL 24 '57  
DD 2627 N.S. PB 2584 # 9a  
500 MCF F12C JUL 31 9a 3 Mill  
CFGPP