

STATE CORPORATION COMMISSION OF KANSAS
OIL & GAS CONSERVATION DIVISION
WELL COMPLETION OR RECOMPLETION FORM
ACO-1 WELL HISTORY
DESCRIPTION OF WELL AND LEASE

Operator: License # 9826
Name Scarth Oil & Gas Company
Address 901 S. Polk
City/State/Zip Amarillo, TX 79101

Purchaser

Operator Contact Person J.F. Howell, III
Phone (806) 373-6932

Contractor: License # 5422
Name Abercrombie Drilling, Inc.

Wellsite Geologist
Phone

Designate Type of Completion

New Well Re-Entry Workover
 Gas SWD Temp Abd
 Inj Delayed Comp.
 Dry Other (Core, Water Supply etc.)

If OWNO: old well info as follows:

Operator
Well Name
Comp. Date
Old Total Depth

WELL HISTORY

Drilling Method:

Mud Rotary Air Rotary Cable

4-11-87 Spud Date
4-19-87 Date Reached TD
4-20-87 Completion Date

4500' Total Depth
PBDT

Amount of Surface Pipe Set and Cemented at 303 feet

Multiple Stage Cementing Collar Used? Yes No

If yes, show depth set feet

If alternate 2 completion, cement circulated from feet depth to w/SX cmt

Cement Company Name

Invoice #

083-21,274

API NO. 15-
County Hodgeman
S/2 SW NE Sec 1 Twp 21 Rge 26 East
X West

2970 Ft North from Southeast Corner of Section
1980 Ft West from Southeast Corner of Section
(Note: Locate well in section plat below)


Lease Name Boxberger Well # 1

Field Name

Producing Formation

Elevation: Ground 2407 KB 2412

Section Plat

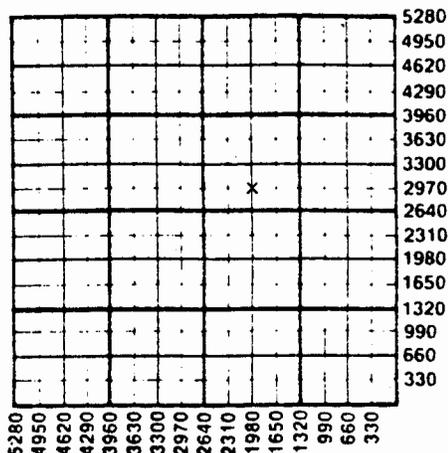

WATER SUPPLY INFORMATION

Disposition of Produced Water: Disposal
Docket # Repressuring

Questions on this portion of the ACO-1 call:
Water Resources Board (913) 296-3717

Source of Water:
Division of Water Resources Permit #

Groundwater Ft North from Southeast Corner
(Well) Ft West from Southeast Corner of
Sec Twp Rge East West

X Surface Water 3960 Ft North from Southeast Corner
(Stream, pond etc.) 1580 Ft West from Southeast Corner
Sec 6 Twp 21 Rge 25 East X West

Other (explain)
(purchased from city, R.W.D. #)

INSTRUCTIONS: This form shall be completed in triplicate and filed with the Kansas Corporation Commission, 200 Colorado Derby Building, Wichita, Kansas 67202, within 120 days of the spud date of any well. Rule 82-3-130, 82-3-107 and 82-3-106 apply.

Information on side two of this form will be held confidential for a period of 12 months if requested in writing and submitted with the form. See rule 82-3-107 for confidentiality in excess of 12 months.

One copy of all wireline logs and drillers time log shall be attached with this form. Submit CP-4 form with all plugged wells. Submit CP-11 form with all temporarily abandoned wells.