

STATE CORPORATION COMMISSION OF KANSAS
OIL & GAS CONSERVATION DIVISION

WELL COMPLETION OR RECOMPLETION FORM
ACO-1 WELL HISTORY

DESCRIPTION OF WELL AND LEASE

Operator: License # 9883
Name Sharon Resources
Address 7100 E. Bellevue Avenue
Suite 201
City/State/Zip Englewood, Colorado 80111

Purchaser Inland Crude

Operator Contact Person Charles B. Davis
Phone (303) 595-9111

Contractor: License # 6033
Name Murfin Drilling

Wellsite Geologist Glenn D. Diehl
Phone (913) 625-7106

Designate Type of Completion
 New Well Re-Entry Workover
 Oil SWD Temp Abd
 Gas Inj Delayed Comp.
 Dry Other (Core, Water Supply etc.)

If OWO: Old well info as follows:
Operator
Well Name
Comp. Date Old Total Depth

WELL HISTORY

Drilling Method:
 Mud Rotary Air Rotary Cable

.11.5.84... .11.13.84.. 5/9/85.....
Spud Date Date Reached TD Completion Date
.444..... .442.....
Total Depth PBTD

Amount of Surface Pipe Set and Cemented at 375 feet
Multiple Stage Cementing Collar Used? Yes No
If yes, show depth set.....feet
If alternate 2 completion, cement circulated
from.....feet depth to.....w/.....SX cmt

API NO. 15-083-21-169
County Hodgeman
NE NW NW Sec 1 Twp 21 Rge 26 East West

4950 Ft North from Southeast Corner of Section
4290 Ft West from Southeast Corner of Section
(Note: Locate well in section plat below)


Lease Name Cheney Well # 1

Field Name

Producing Formation Mississippian Conglomerate

Elevation: Ground 2413 KB 2421

Section Plat

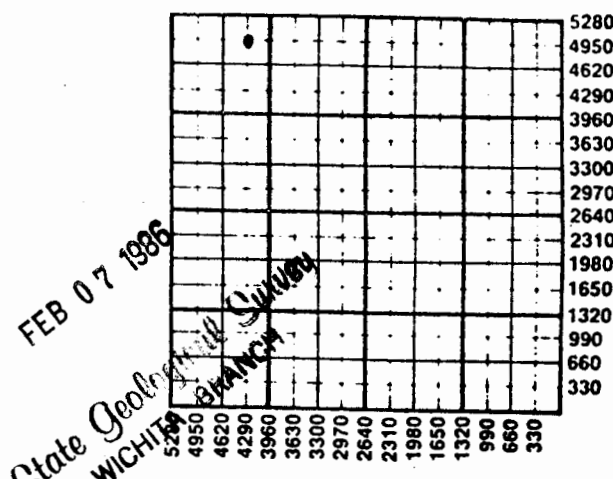

WATER SUPPLY INFORMATION

Disposition of Produced Water: Disposal Repressuring
Docket #

Questions on this portion of the ACO-1 call:
Water Resources Board (913) 296-3717

Source of Water:
Division of Water Resources Permit #

Groundwater.....Ft North from Southeast Corner
(Well)Ft West from Southeast Corner of
Sec Twp Rge East West

Surface Water.....Ft North from Southeast Corner
(Stream, pond etc).....Ft West from Southeast Corner
Sec Twp Rge East West

Other (explain).....
(purchased from city, R.W.D. #)

INSTRUCTIONS: This form shall be completed in duplicate and filed with the Kansas Corporation Commission, 200 Colorado Derby Building, Wichita, Kansas 67202, within 90 days after completion or recompletion of any well. Rule 82-3-130 and 82-3-107 apply.

Information on side two of this form will be held confidential for a period of 12 months if requested in writing and submitted with the form. See rule 82-3-107 for confidentiality in excess of 12 months. One copy of all wireline logs and drillers time log shall be attached with this form. Submit CP-4 form with all plugged wells. Submit CP-111 form with all temporarily abandoned wells.

SIDE TWO

Operator Name Sharon Resources Lease Name Cheney Well

Sec. 1 Twp. 21 Rge. 26 East West County Hodgeman

WELL LOG

INSTRUCTIONS: Show important tops and base of formations penetrated. Detail all cores. Report all drill tests giving interval tested, time tool open and closed, flowing and shut-in pressures, whether shut-in pressure reached static level, hydrostatic pressures, bottom hole temperature, fluid recovery, and flow rate. If gas to surface during test. Attach extra sheet if more space is needed. Attach copy of log.

Drill Stem Tests Taken Yes No
 Samples Sent to Geological Survey Yes No
 Cores Taken Yes No

Formation Description
 Log Sample

Name Top Bottom

DST's Attached

Geologists Report Attached

METHOD OF COMPLETION

Production Interval

Disposition of gas: Vented Open Hole Perforation
 Sold Other (Specify)
 Used on Lease Dually Completed
 Commingled



Wichita

CASING RECORD New Used

Report all strings set-conductor, surface, intermediate, production, etc.

Purpose of String	Size Hole Drilled	Size Casing Set (in O.D.)	Weight Lbs/Ft.	Setting Depth	Type of Cement	#Sacks Used	Type and Percent Additives
..... Surface	12.1/4	8.5/8	24	375	60-40POZ	200	2% Gel 3% Ca Cl
..... Production	7.7/8	5.1/2	14	4446	Class A	200	5% Calseal 18% salt

PERFORATION RECORD

Acid, Fracture, Shot, Cement Squeeze Record

Shots Per Foot	Specify Footage of Each Interval Perforated	(Amount and Kind of Material Used)	Depth
..... 2	4385-91	1250 gal SGA Retarded acid 15% HCL	4385-91
..... 2	4372-76	350 gal Fe Acid 15% HCL 250 gal Fe Acid 10% HCL 250 gal Demulsion Acid 15% HCL	4385-9 4365-91

TUBING RECORD Size 2 7/8 Set At 4418 Packer at _____ Liner Run Yes No

Date of First Production _____ Producing Method Flowing Pumping Gas Lift Other (explain).....